

Borough Council of
**King's Lynn &
 West Norfolk**
 Tel. 01553 616200
 Email: ldf@west-norfolk.gov.uk



Bawsey
Evolved DRAFT Development Boundary Suggestion

Local Plan review (2016 - 2036)
'Smaller Villages and Hamlets'



Scale
1:5,000

 Drawn by
FB/PP


Date
04/08/2017




 Reference Number
001b


Legend

-  Draft boundary suggestions reviewed
-  First draft boundary suggestion

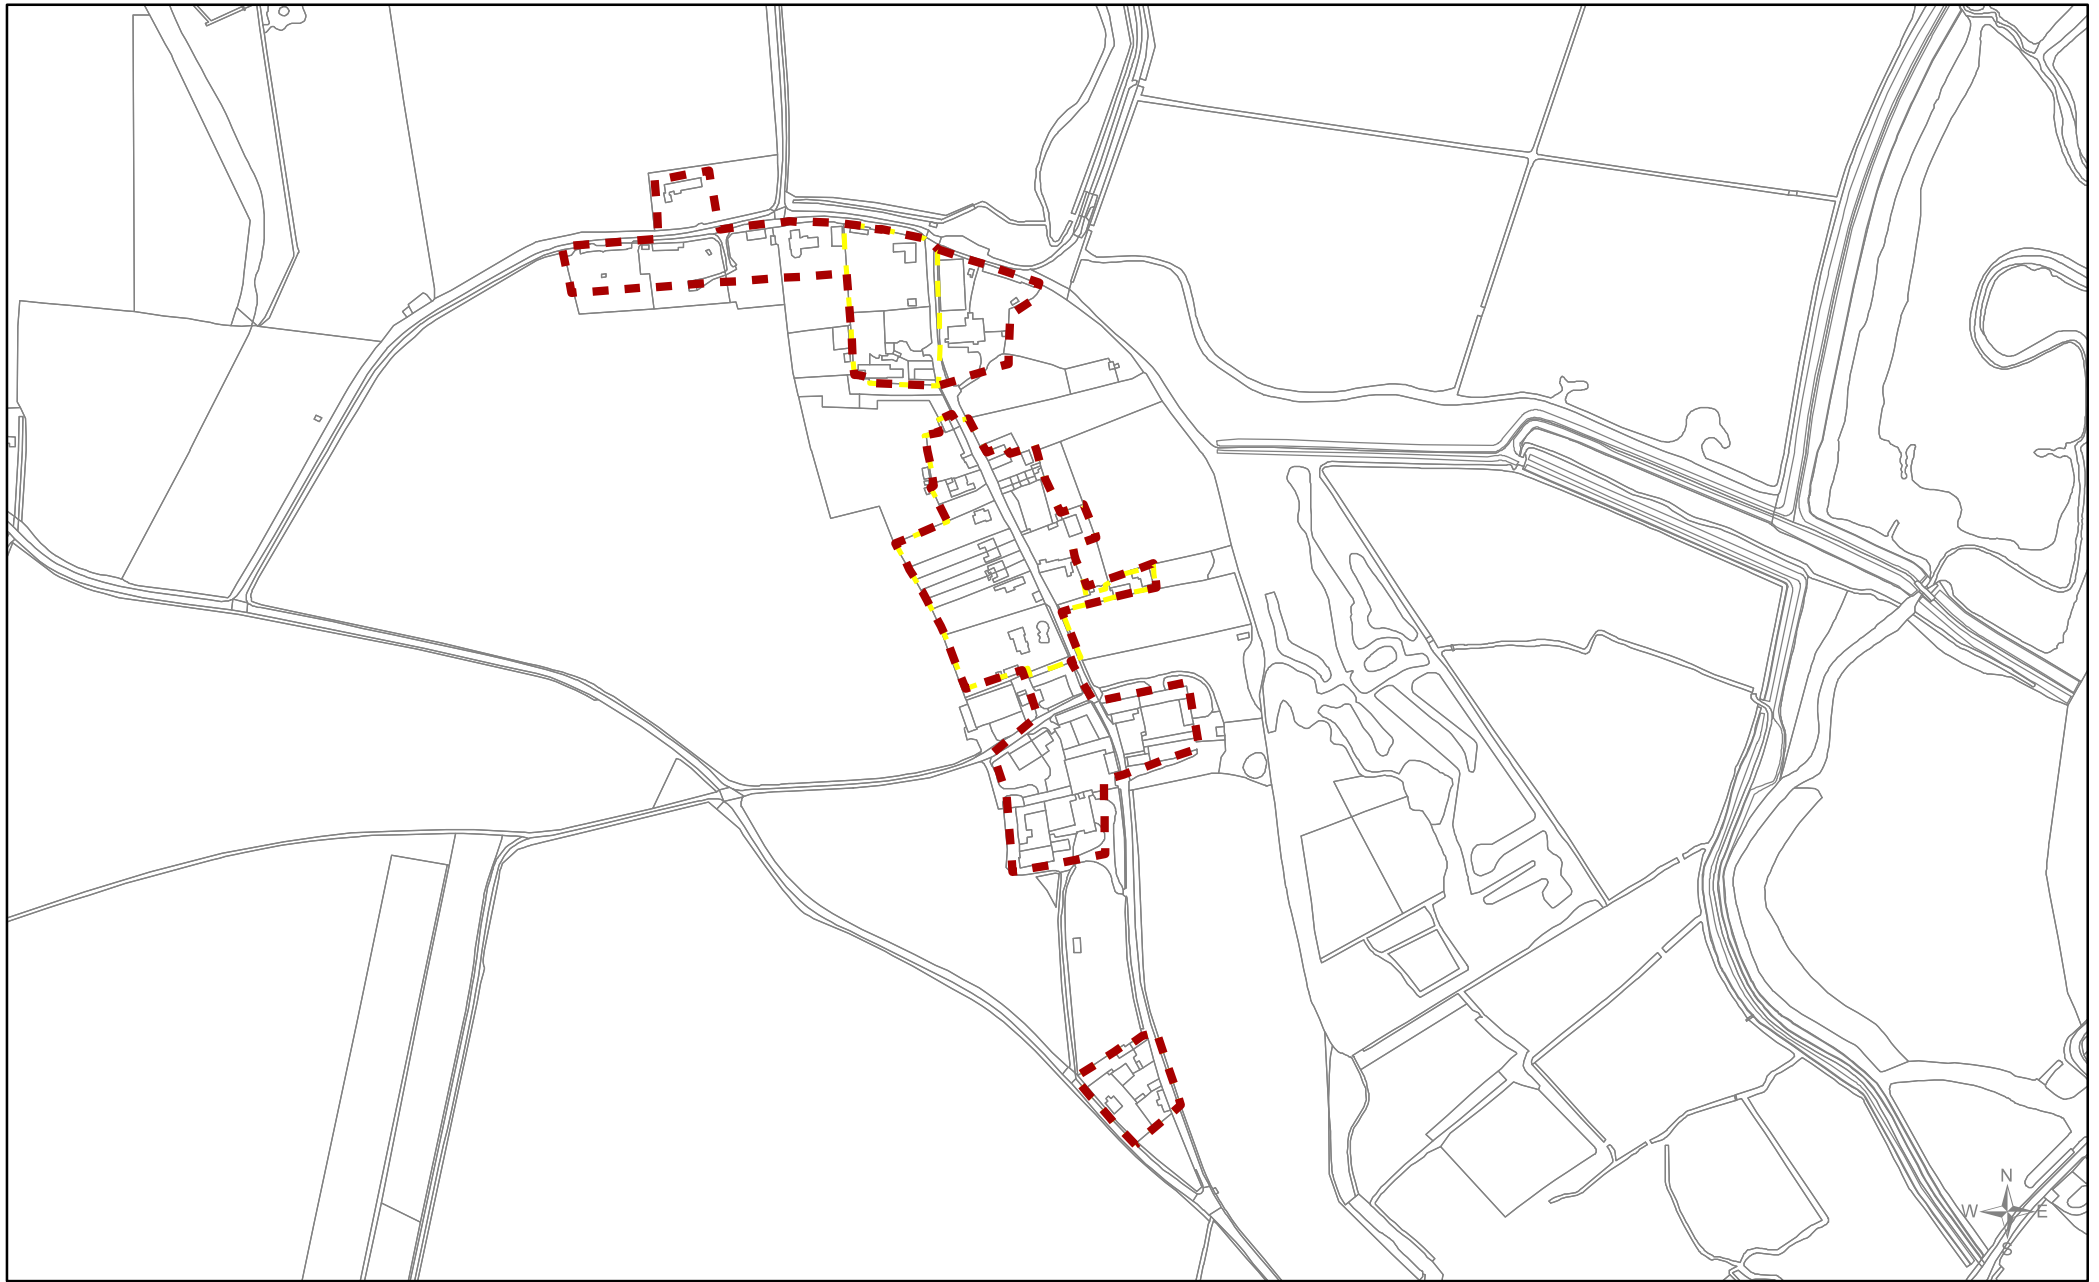
© Crown copyright and
 database rights 2017
 Ordnance Survey 100024314




Borough Council of King's Lynn & West Norfolk Tel. 01553 616200 Email: ldf@west-norfolk.gov.uk 	Burnham Norton Evolved DRAFT Development Boundary Suggestion	Scale 1:5,000	Date 04/08/2017	Legend  Draft boundary suggestions reviewed  First draft boundary suggestion	© Crown copyright and database rights 2017 Ordnance Survey 100024314
	Local Plan review (2016 - 2036) 'Smaller Villages and Hamlets'	Drawn by FB/PP	Reference Number 002b		

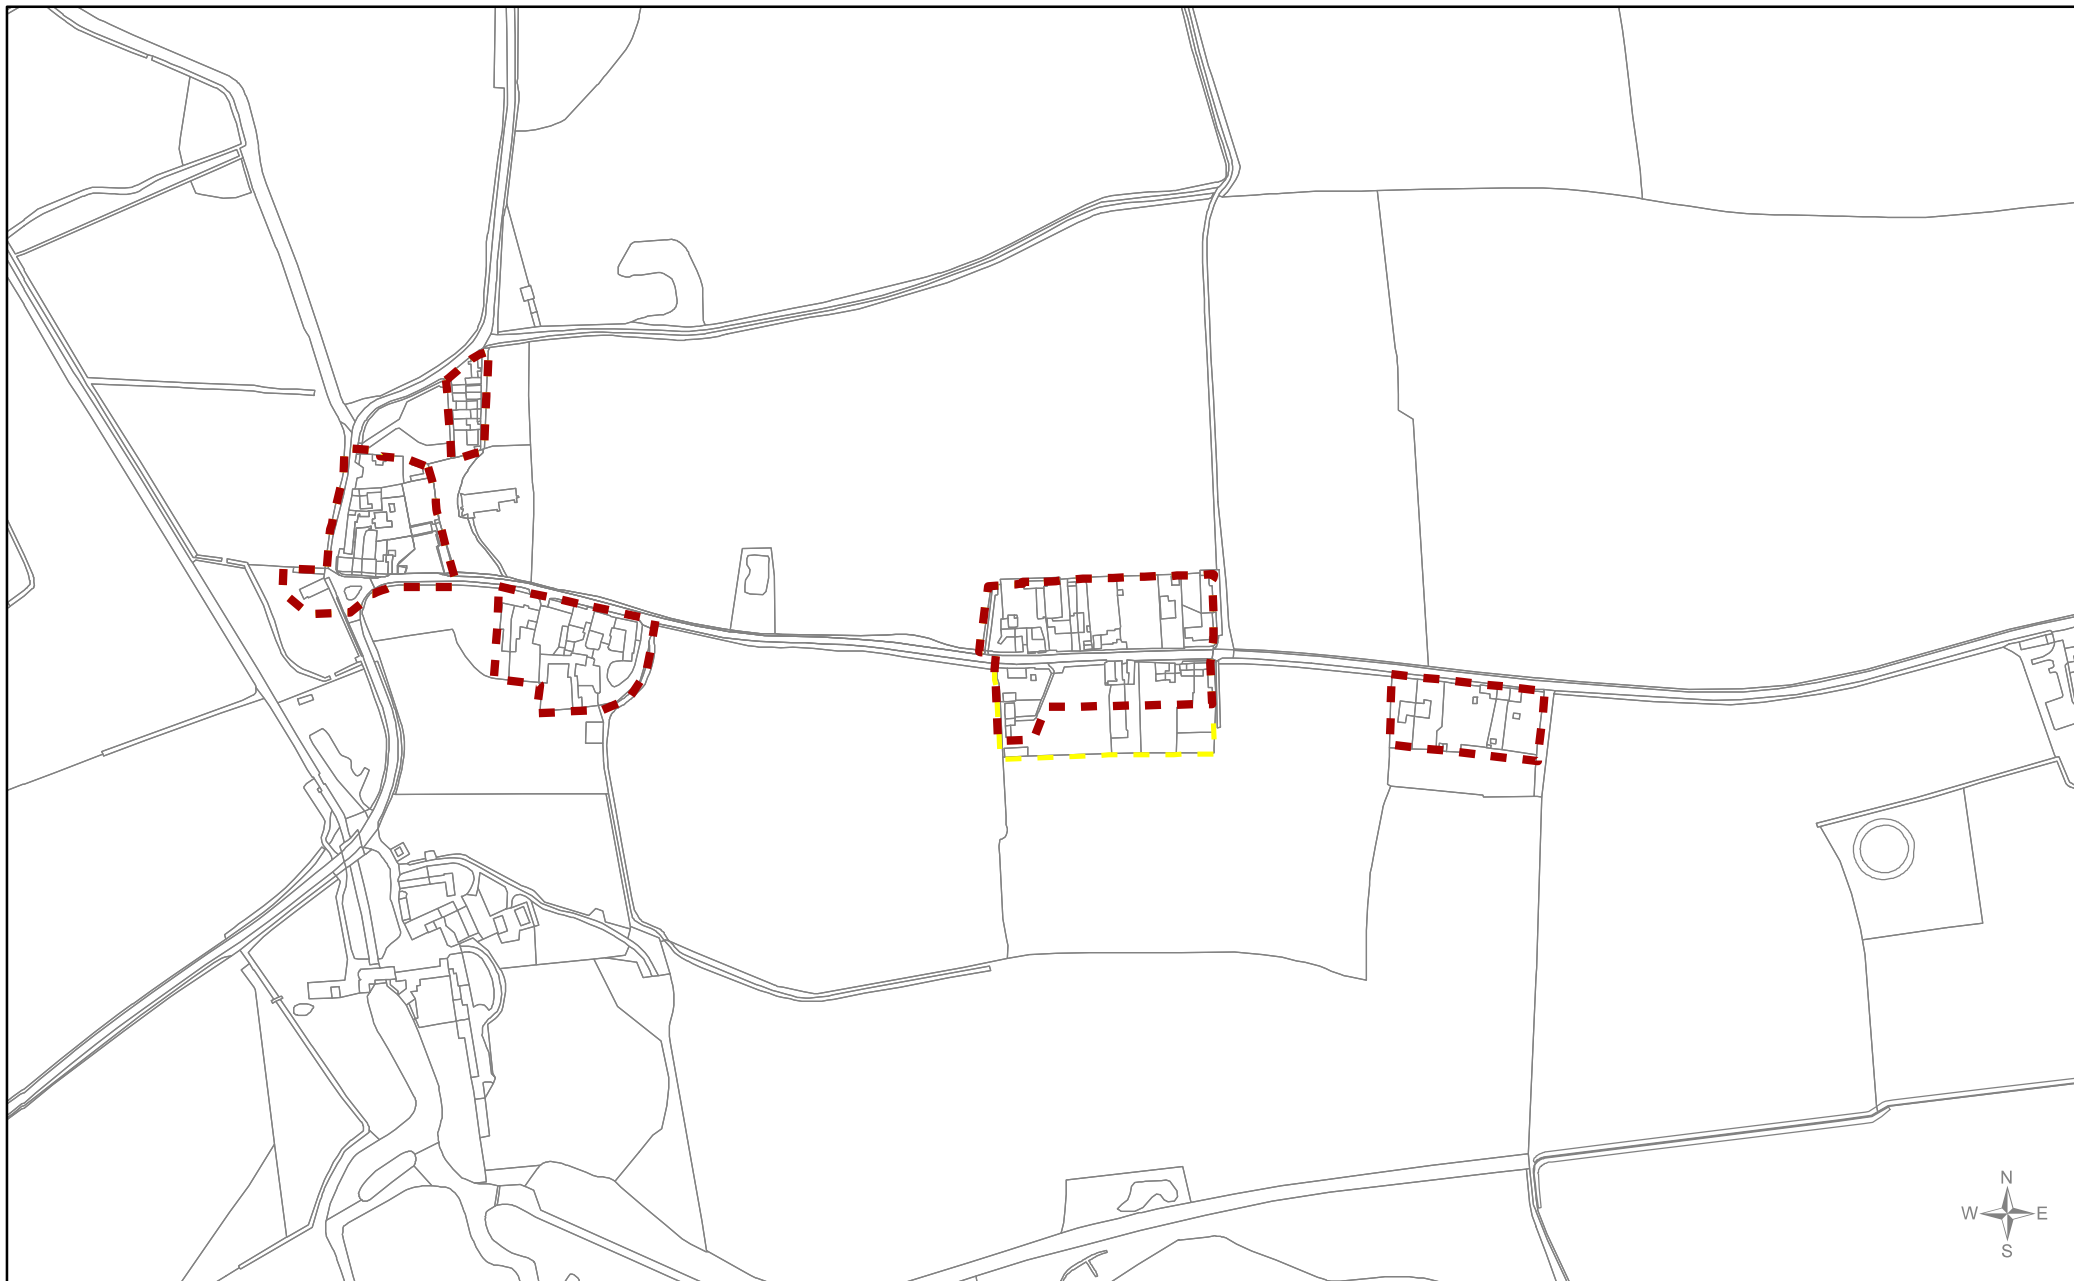



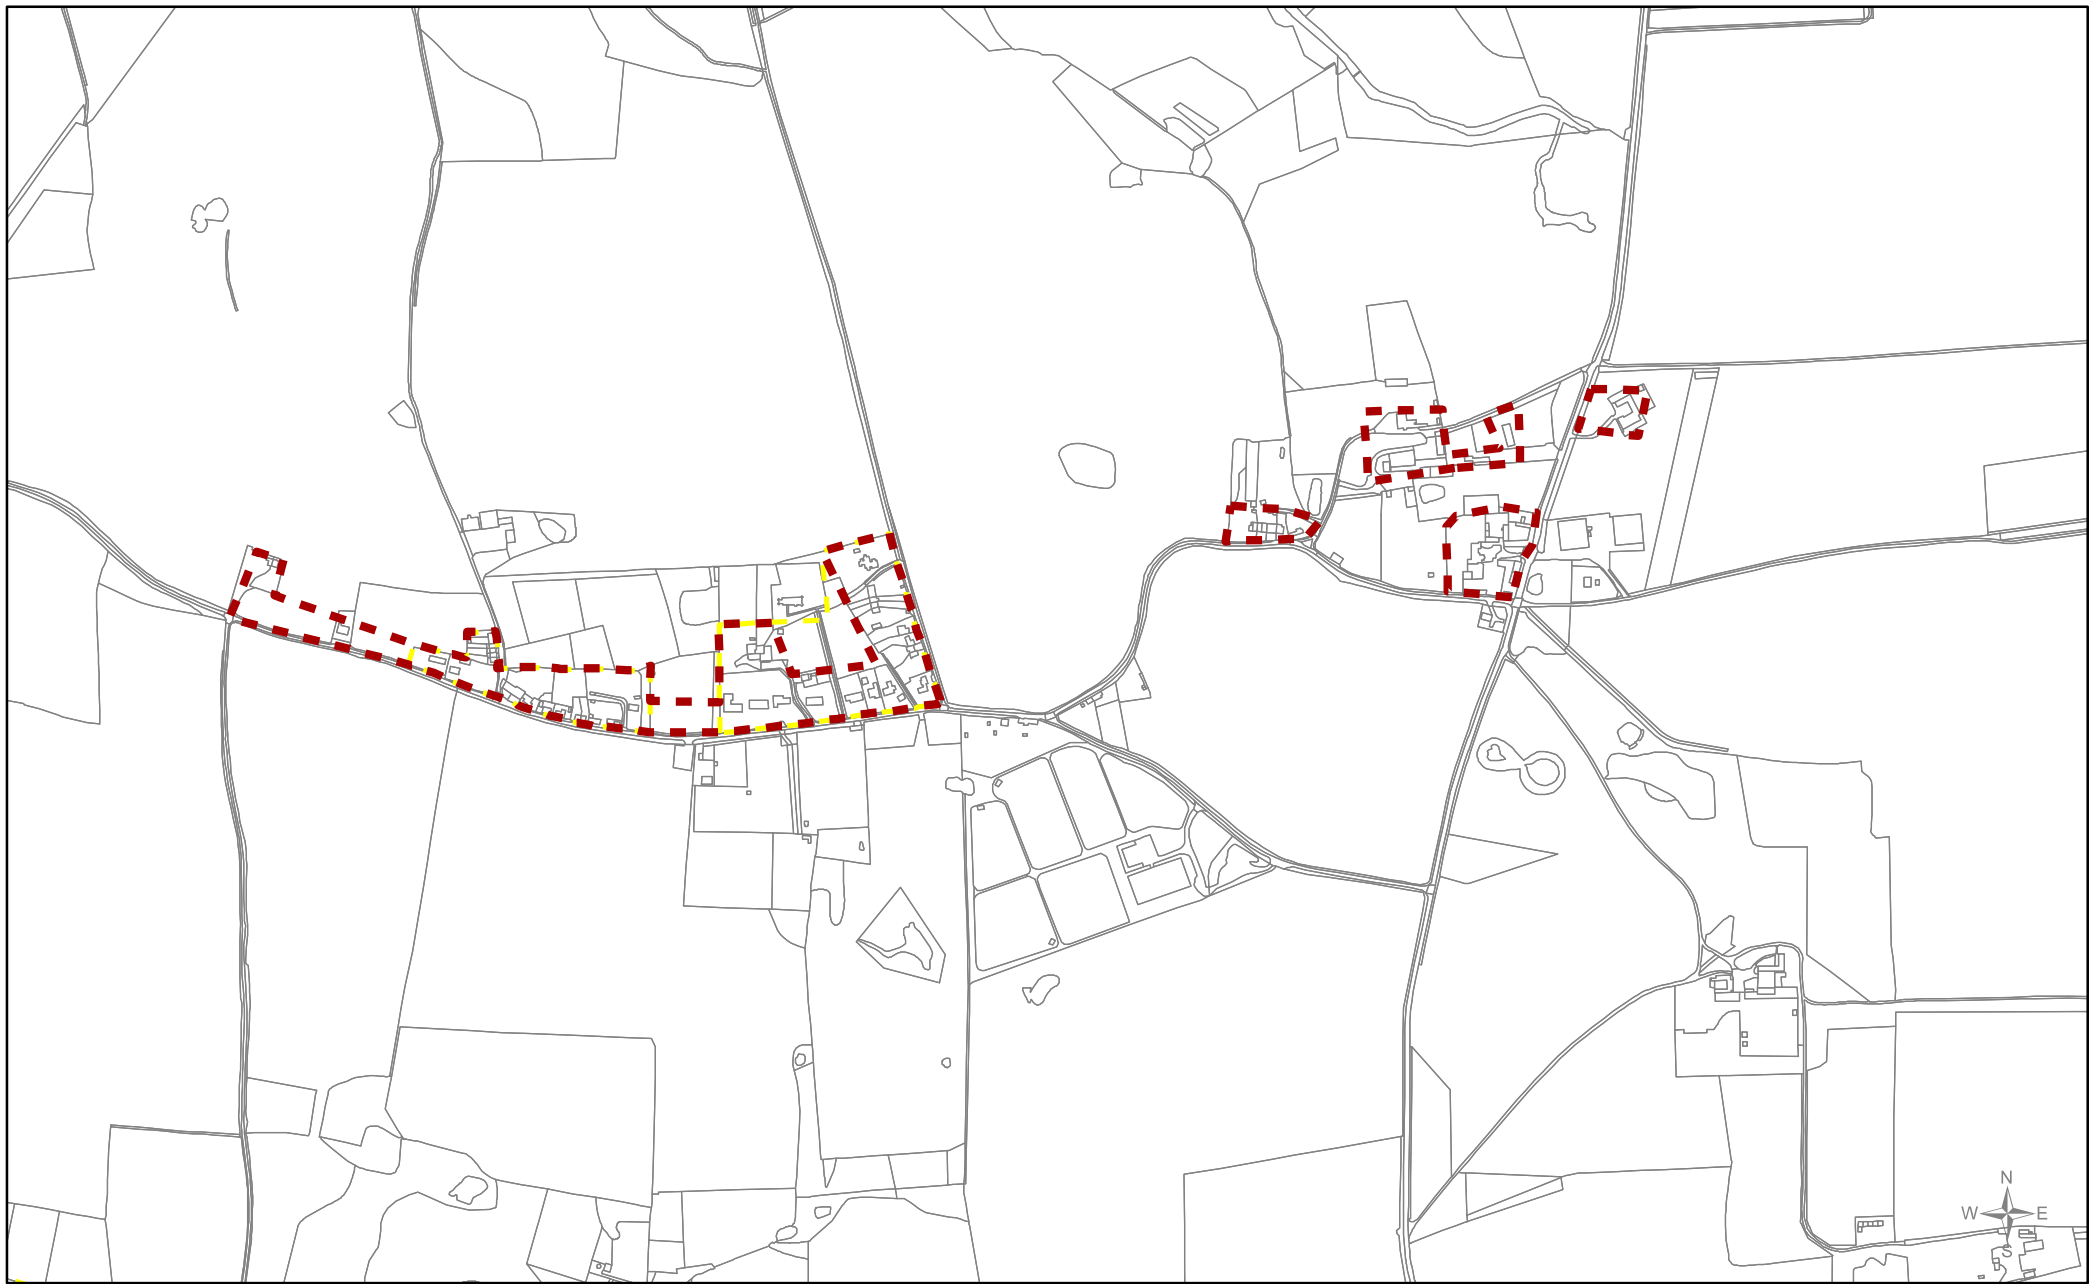

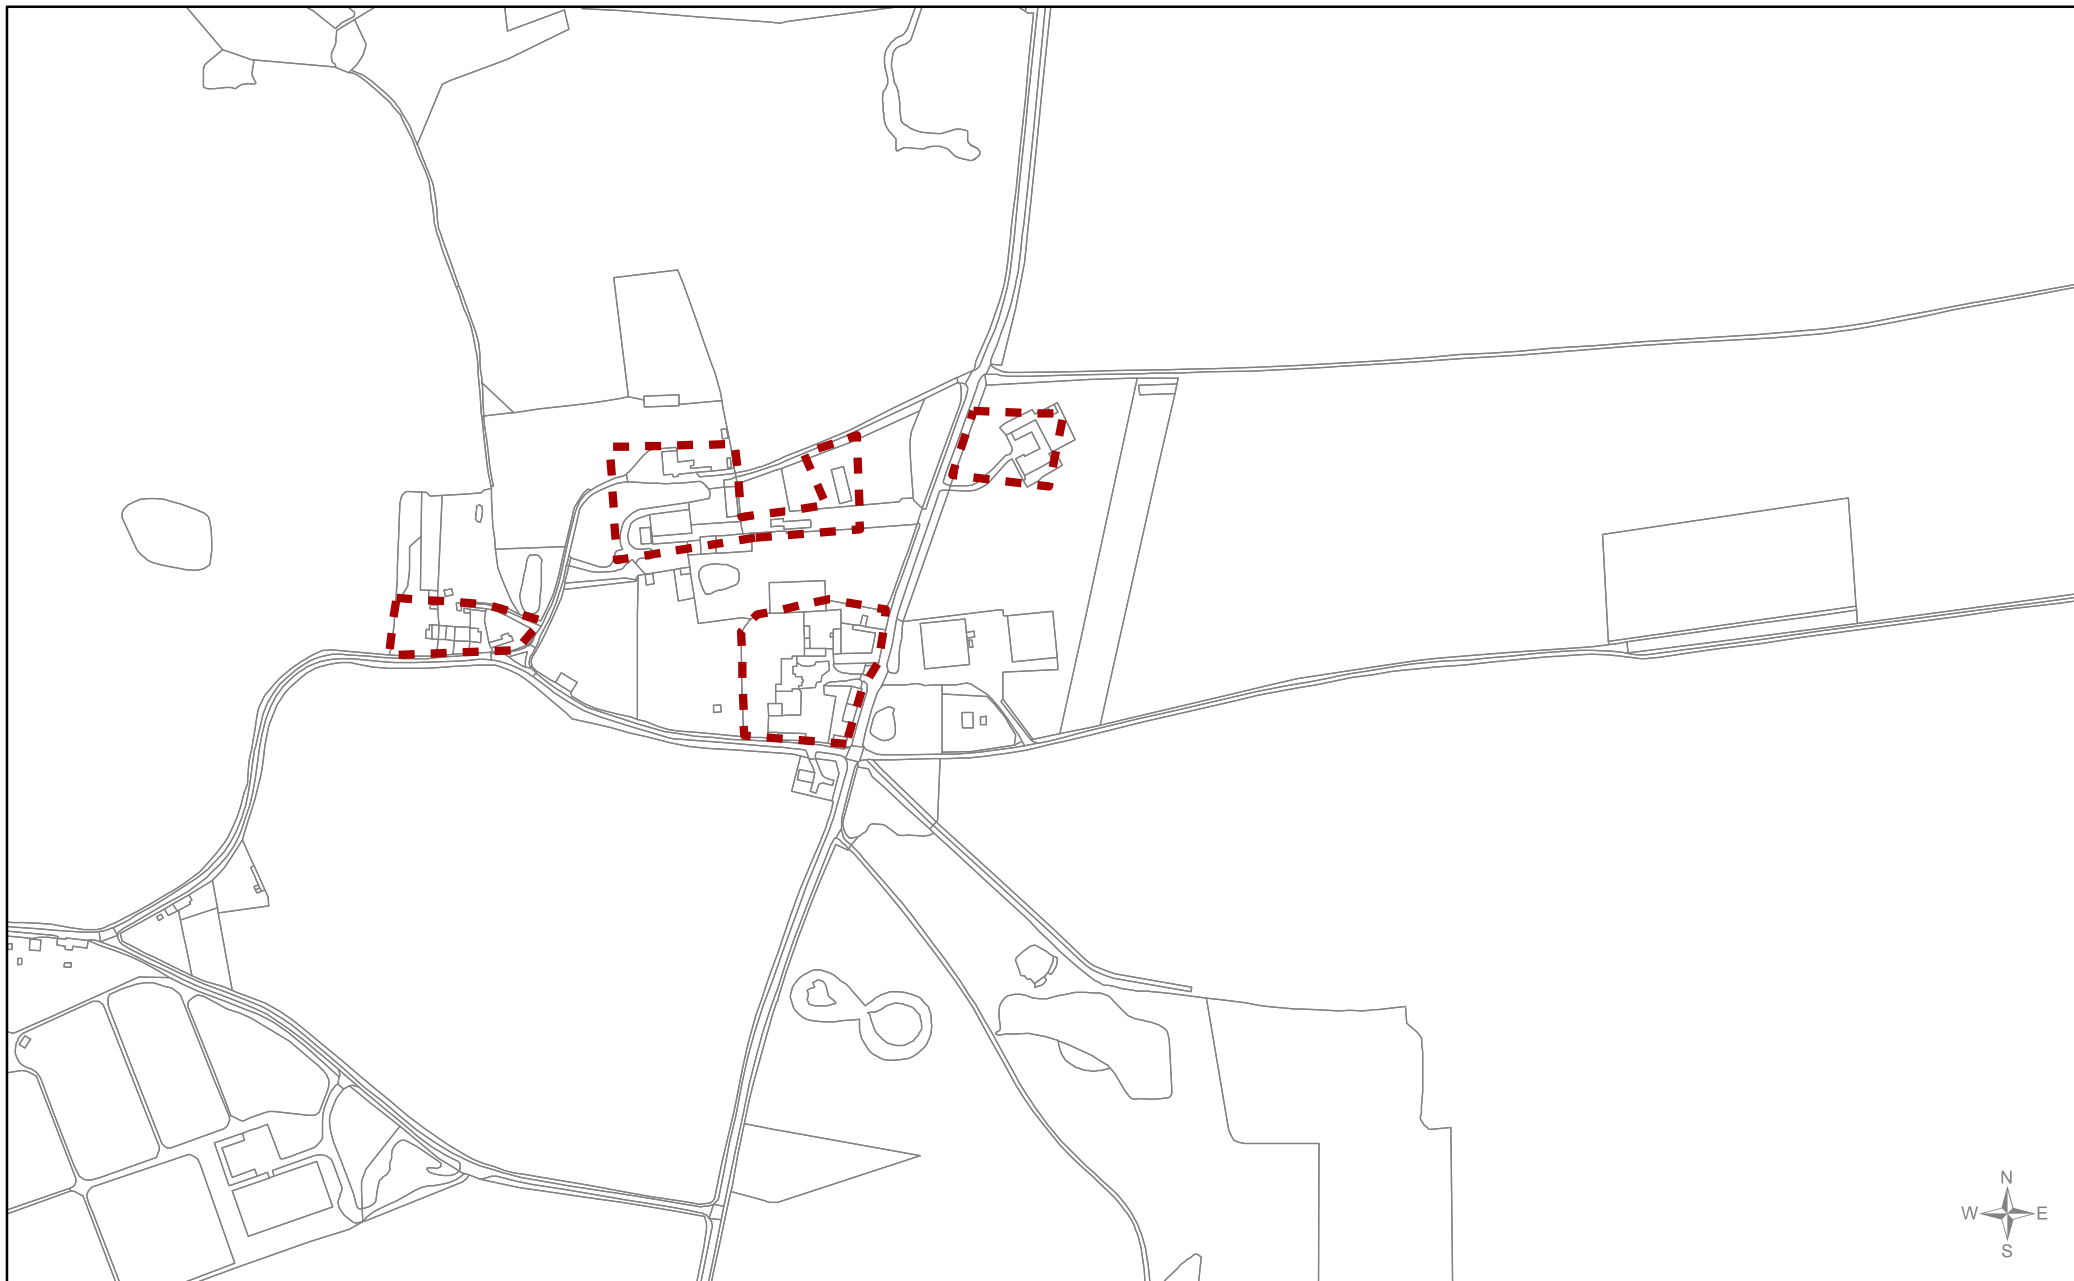

Borough Council of
**King's Lynn &
 West Norfolk**
 Tel. 01553 616200
 Email: ldf@west-norfolk.gov.uk



Congham EAST
Evolved DRAFT Development Boundary Suggestion



Local Plan review (2016 - 2036)
'Smaller Villages and Hamlets'

Scale
1:5,000


 Drawn by
FB/PP

Date
04/08/2017

 Reference Number
005b_EAST

Legend
 Draft boundary suggestions reviewed
 First draft boundary suggestion

© Crown copyright and
 database rights 2017
 Ordnance Survey 100024314

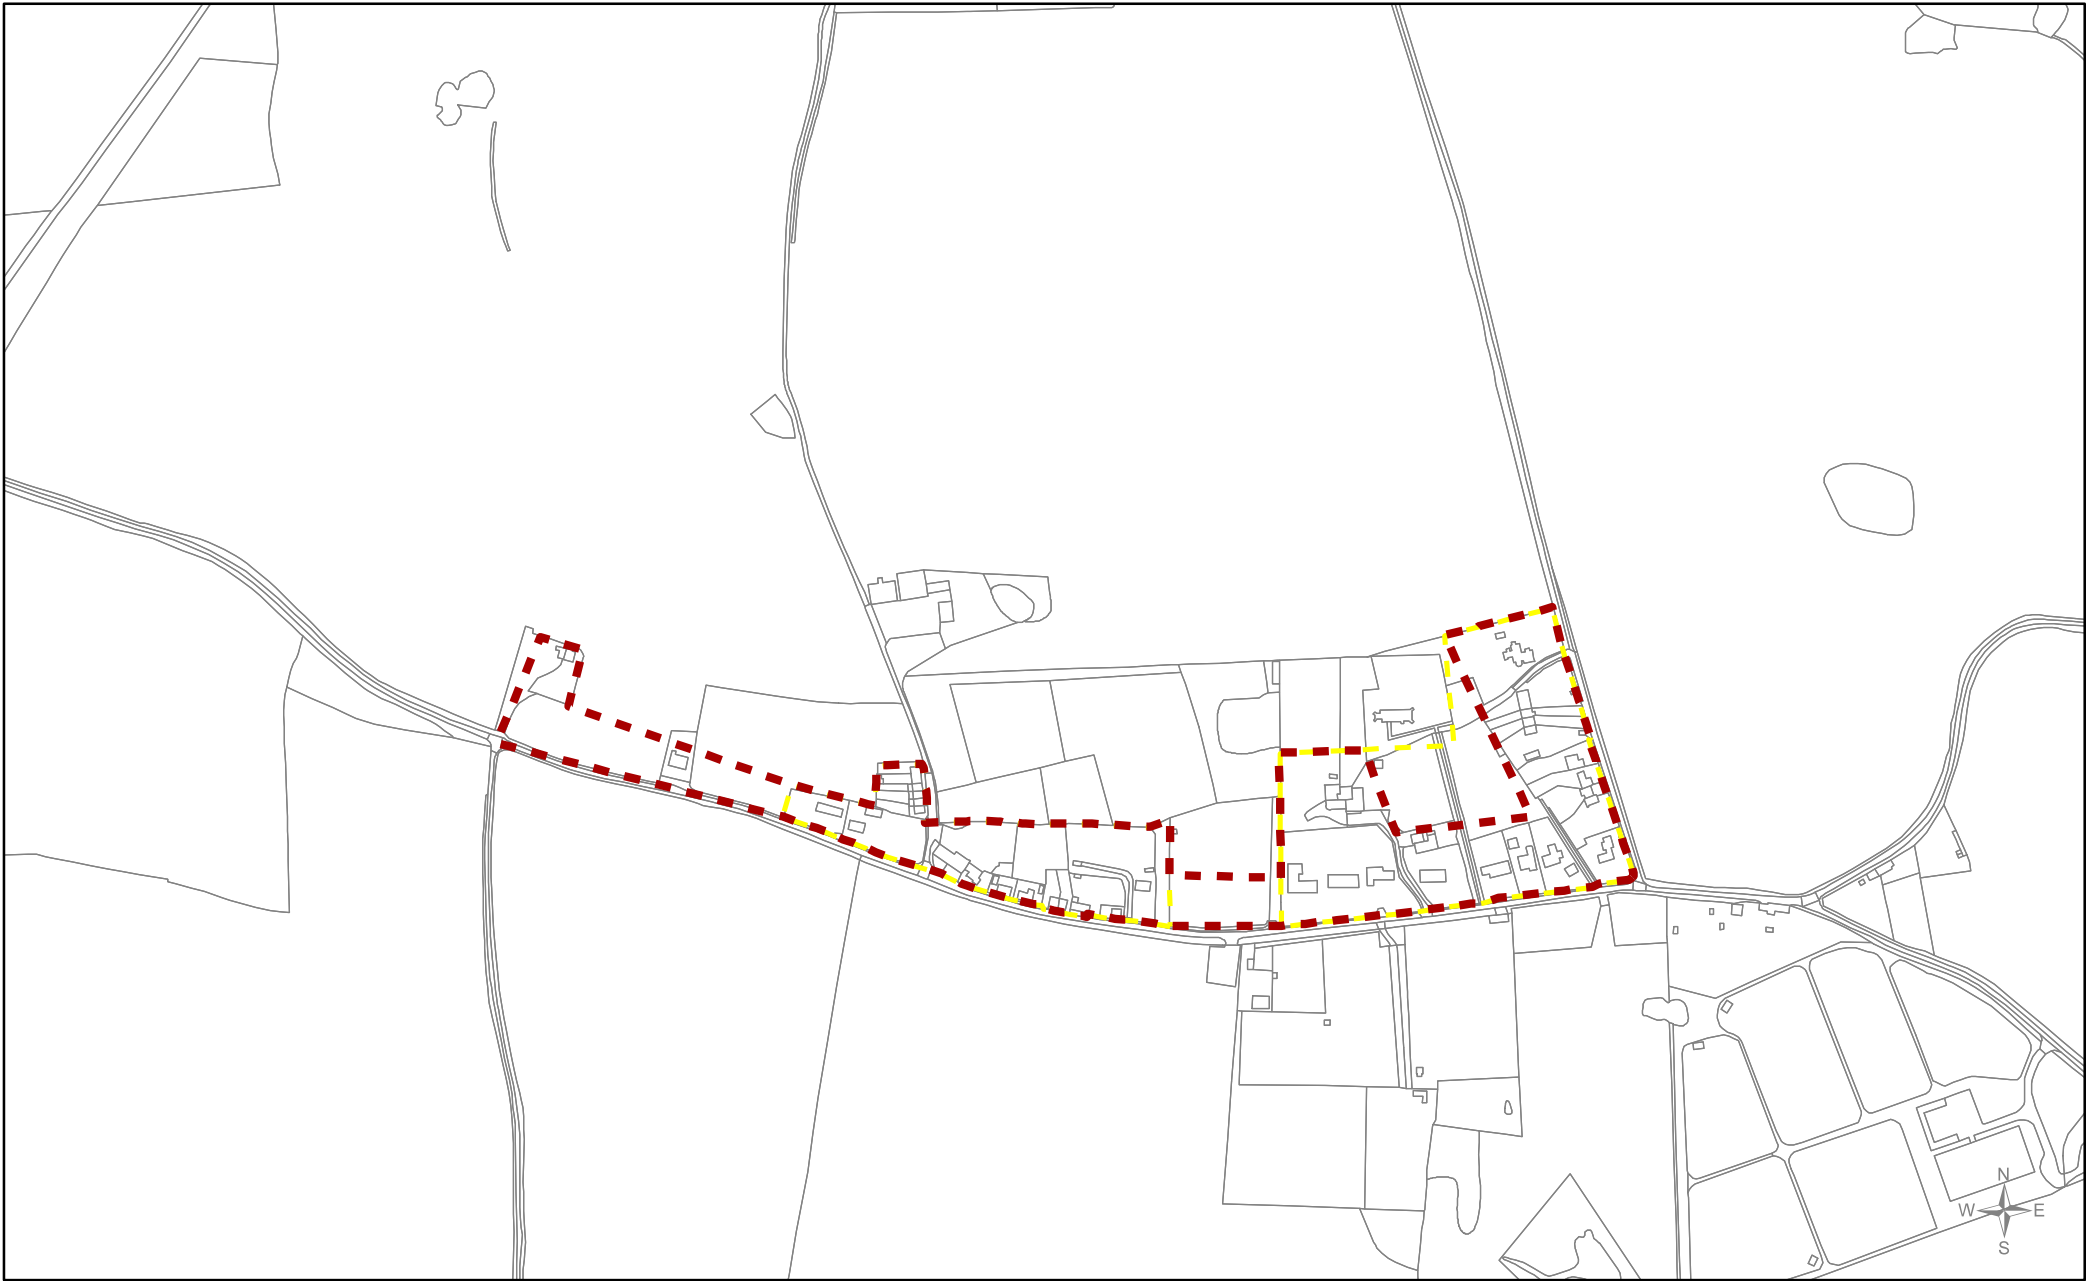

Borough Council of
**King's Lynn &
 West Norfolk**
 Tel. 01553 616200
 Email: ldf@west-norfolk.gov.uk



Congham WEST
Evolved DRAFT Development Boundary Suggestion

Local Plan review (2016 - 2036)
'Smaller Villages and Hamlets'



Scale
1:5,000

 Drawn by
FB/PP

Date
04/08/2017




 Reference Number
005b_WEST


Legend




-  Draft boundary suggestions reviewed
-  First draft boundary suggestion


© Crown copyright and
 database rights 2017
 Ordnance Survey 100024314



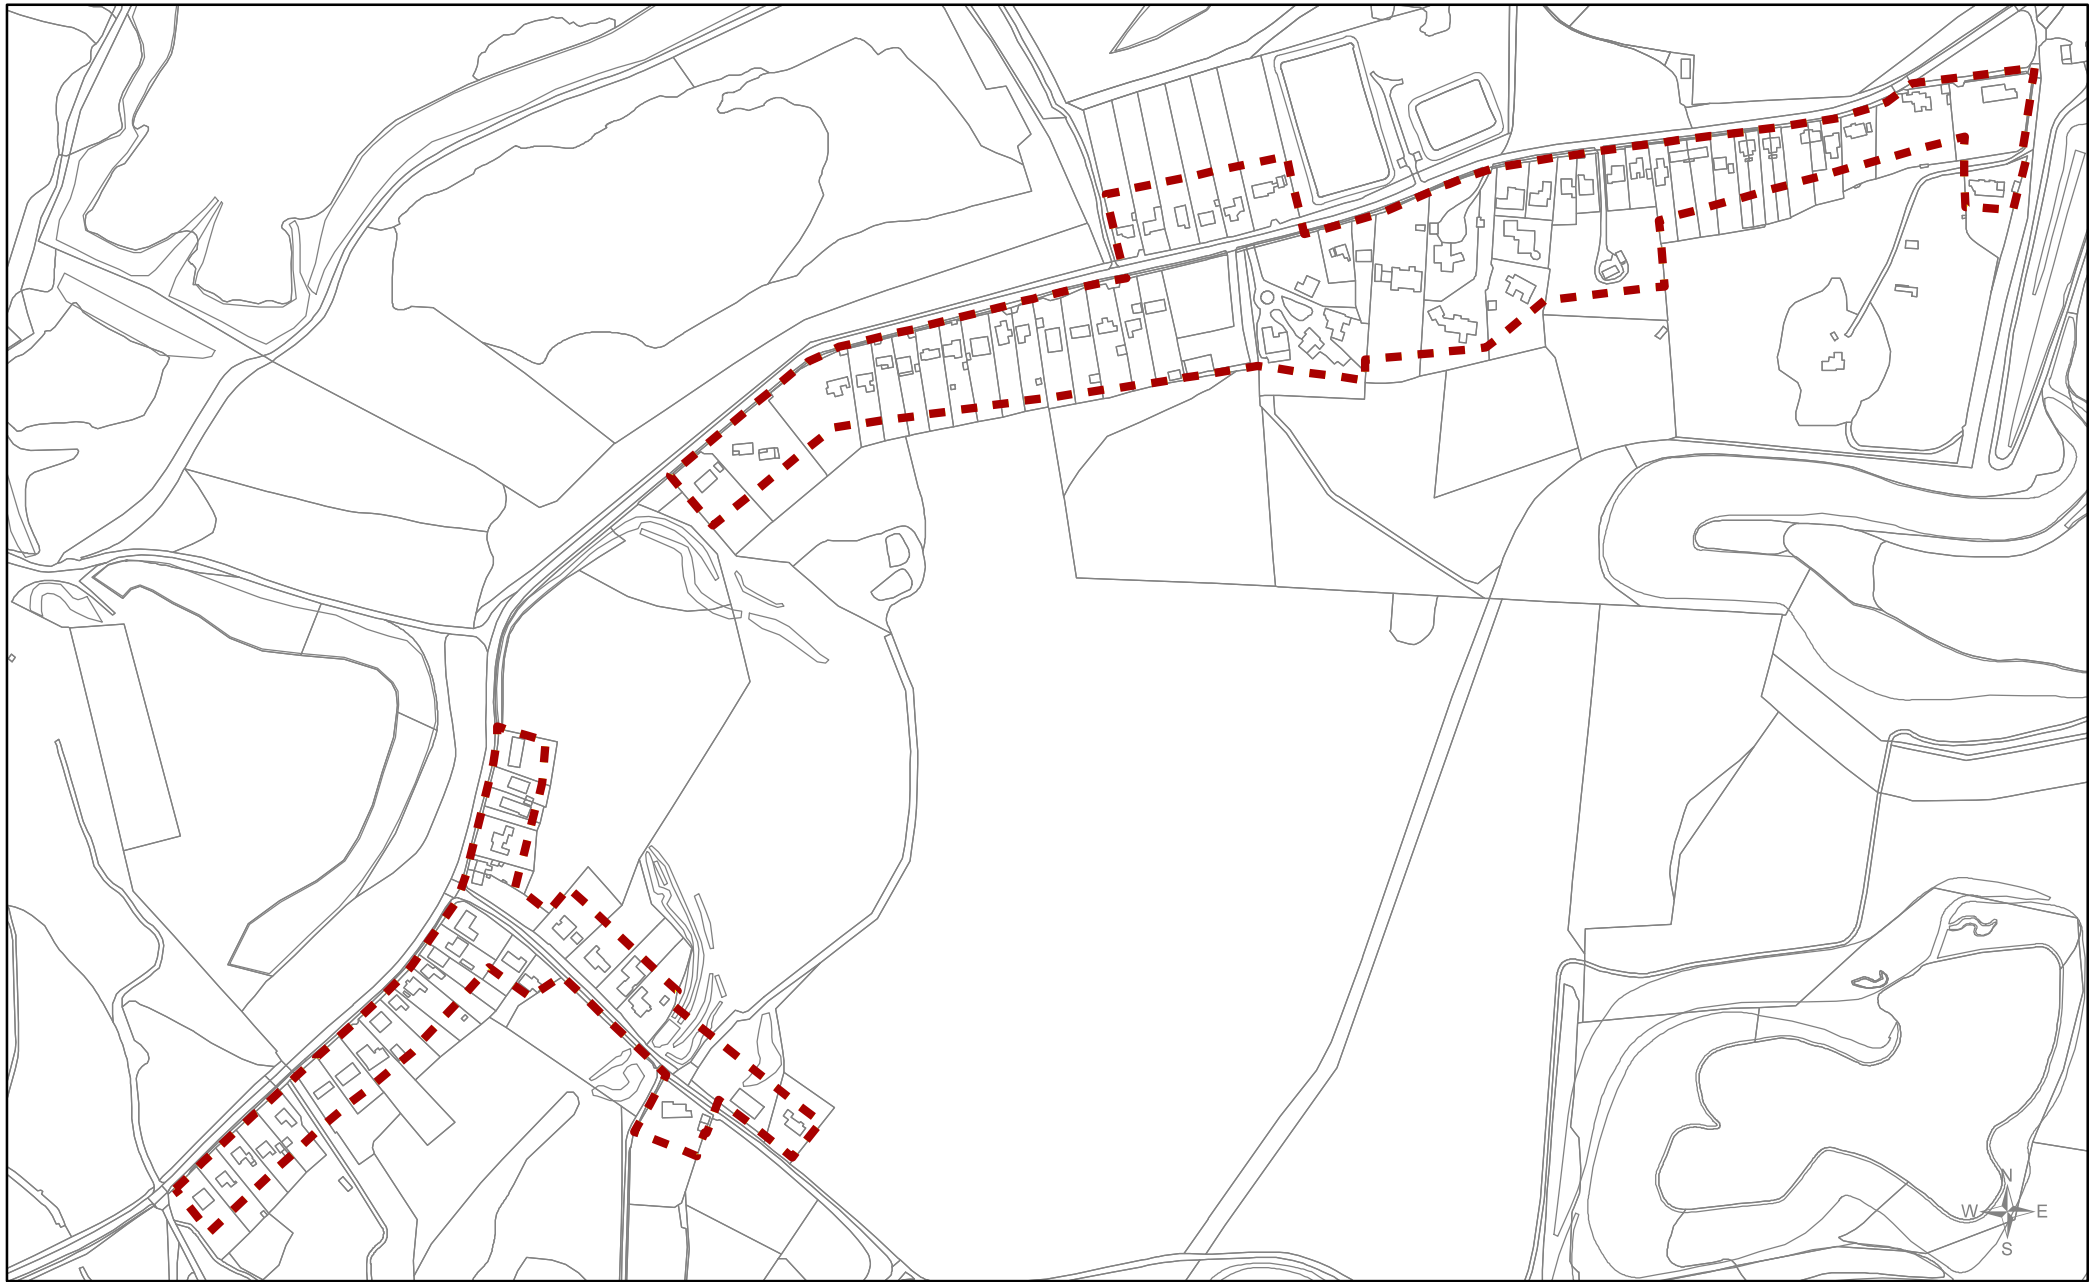


Borough Council of King's Lynn & West Norfolk Tel. 01553 616200 Email: ldf@west-norfolk.gov.uk 	Gayton Thorpe Evolved DRAFT Development Boundary Suggestion		Scale 1:5,000	Date 04/08/2017	Legend  Draft boundary suggestions reviewed  First draft boundary suggestion	© Crown copyright and database rights 2017 Ordnance Survey 100024314
	Local Plan review (2016 - 2036) 'Smaller Villages and Hamlets'		Drawn by FB/PP	Reference Number 006b		



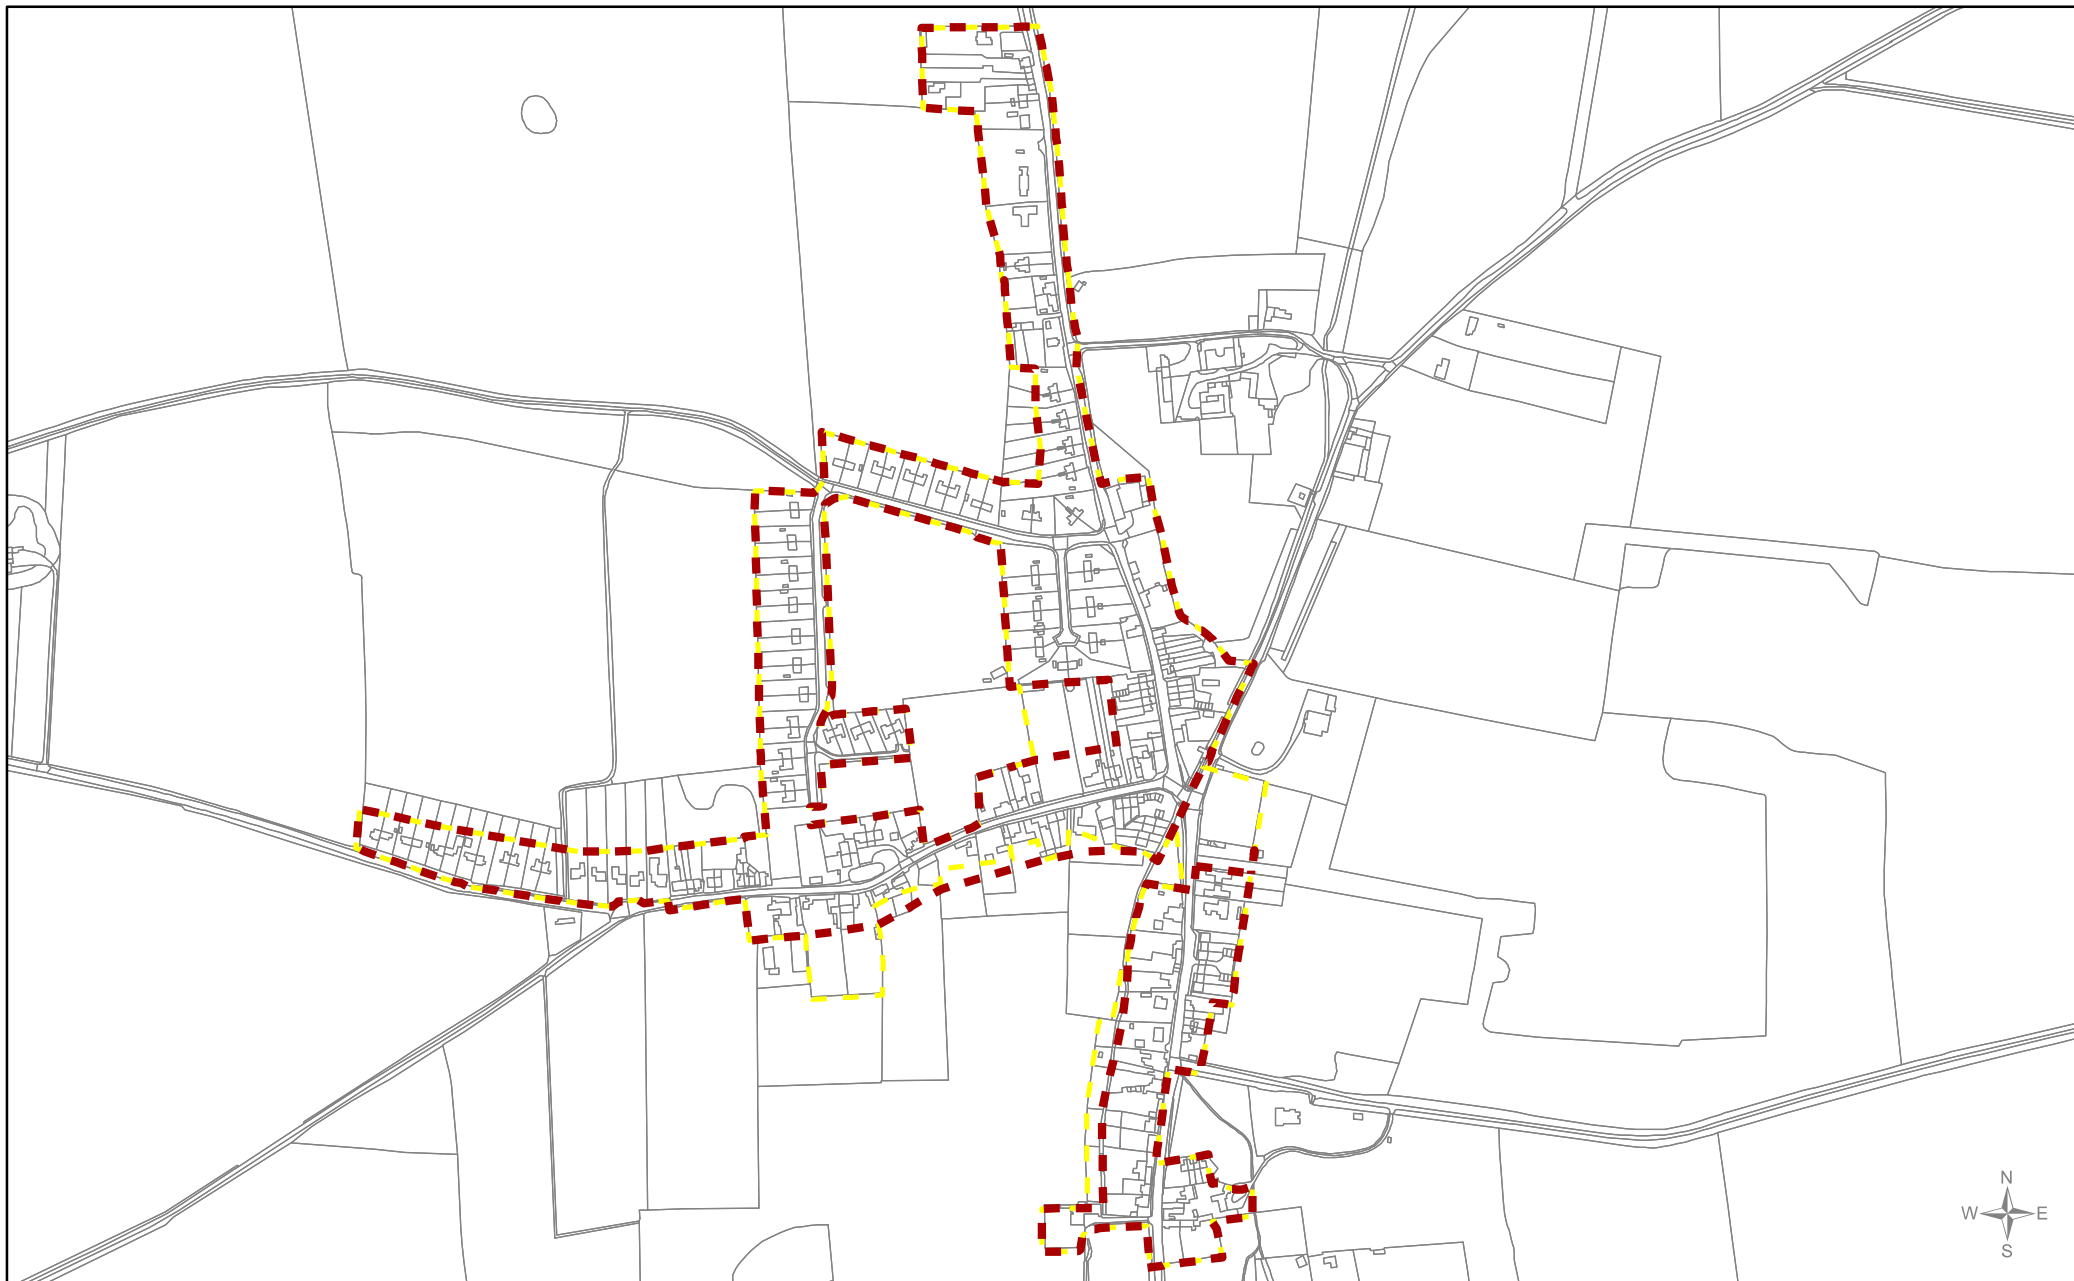


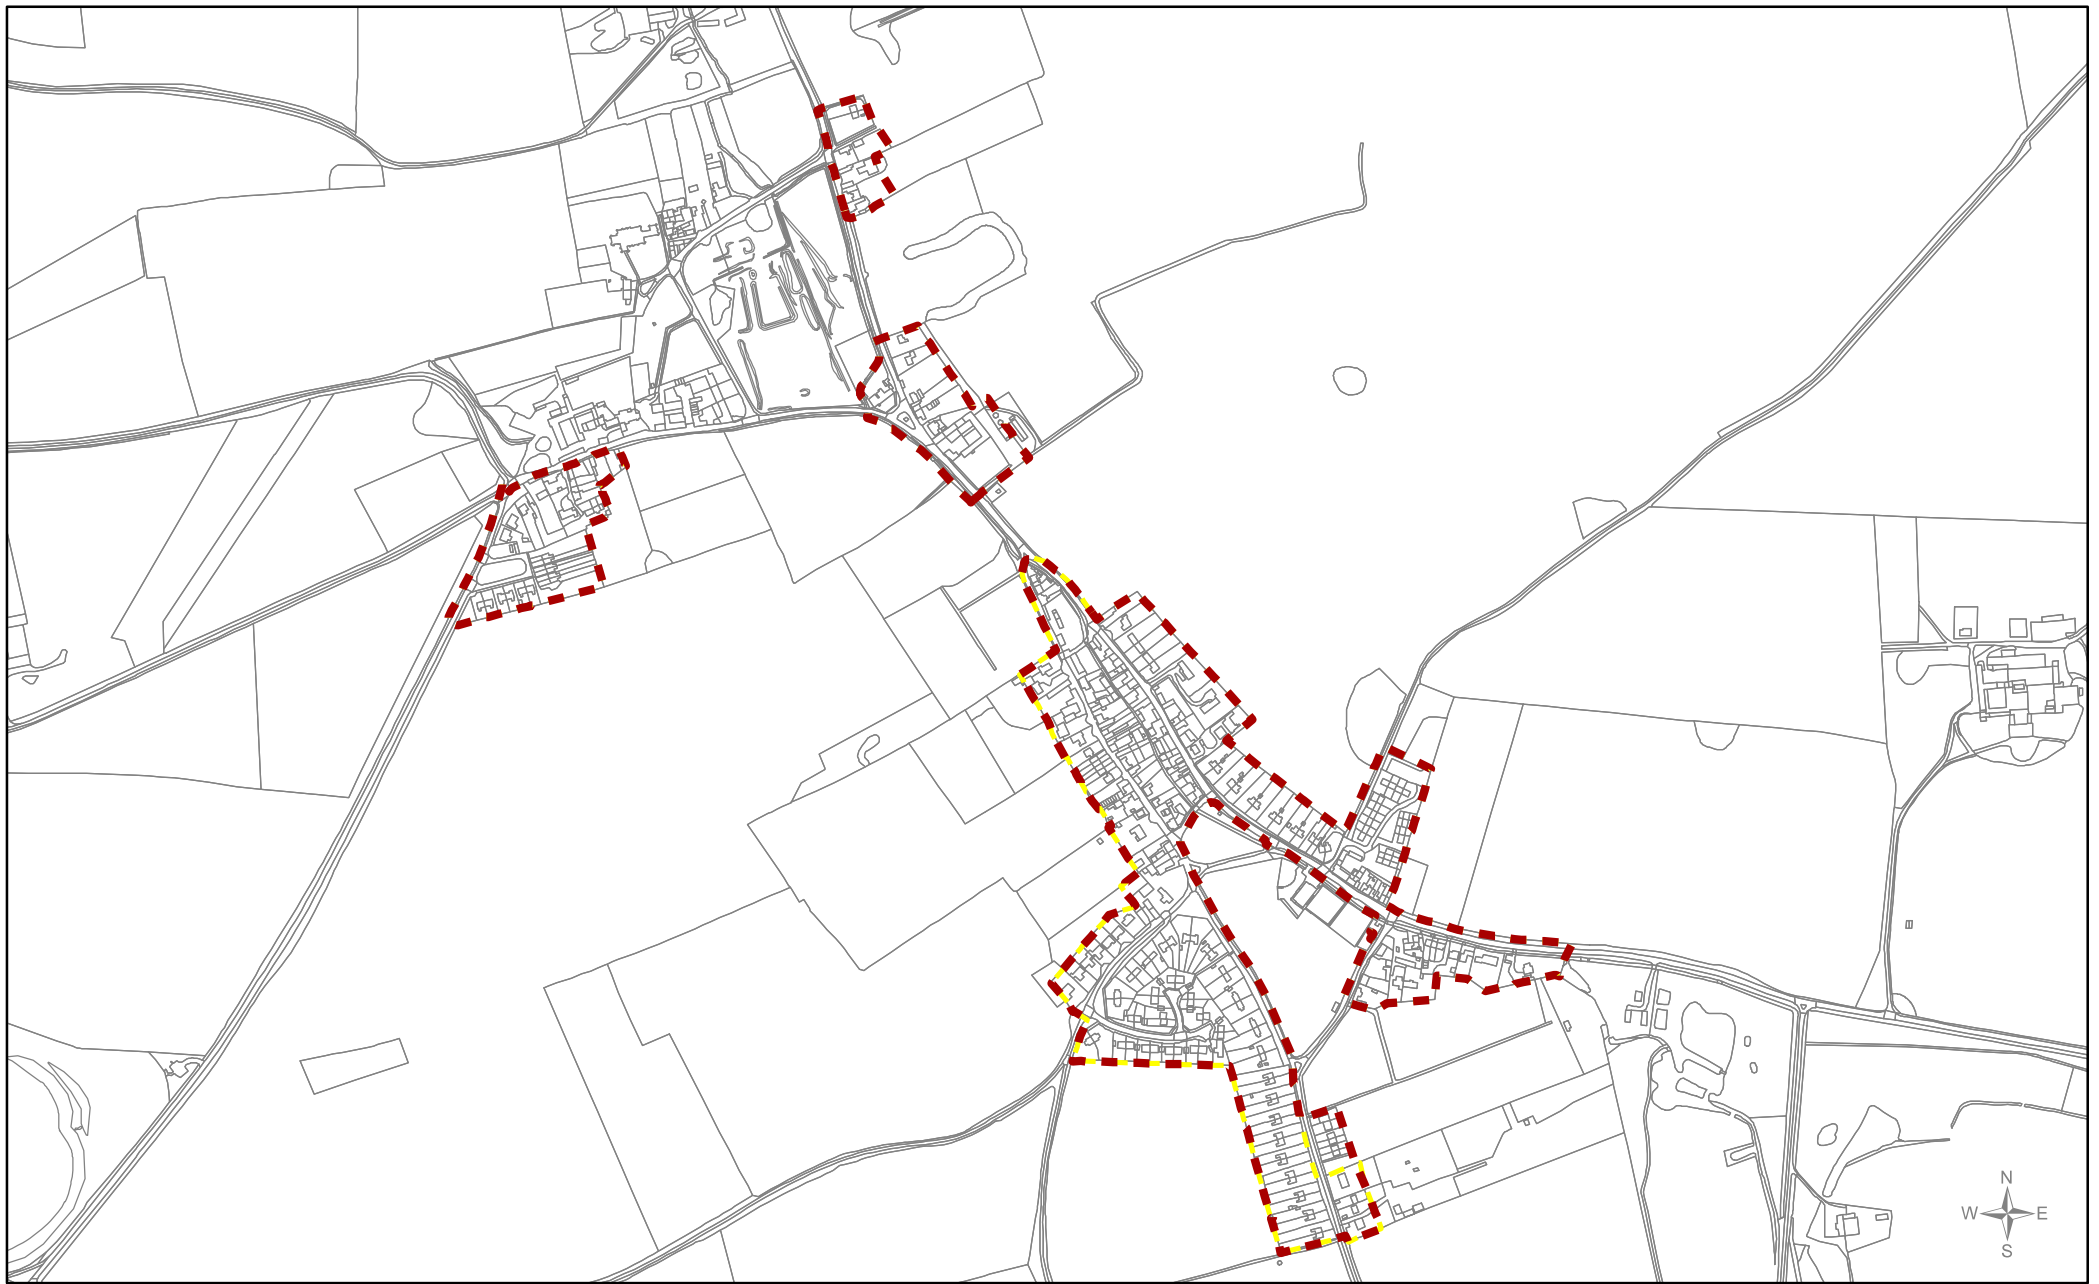
<p>Borough Council of King's Lynn & West Norfolk Tel. 01553 616200 Email: ldf@west-norfolk.gov.uk</p> 	<p align="center">Leziate Evolved DRAFT Development Boundary Suggestion</p> <hr/> <p align="center">Local Plan review (2016 - 2036) 'Smaller Villages and Hamlets'</p>	<p>Scale 1:5,000</p> <hr/> <p>Drawn by FB/PP</p>	<p>Date 04/08/2017</p> <hr/> <p>Reference Number 007b</p>	<p>Legend</p> <ul style="list-style-type: none">  Draft boundary suggestions reviewed  First draft boundary suggestion 	<p>© Crown copyright and database rights 2017 Ordnance Survey 100024314</p>
---	--	--	---	---	---



<p>Borough Council of King's Lynn & West Norfolk Tel. 01553 616200 Email: ldf@west-norfolk.gov.uk</p> 	<p align="center">North Creake Evolved DRAFT Development Boundary Suggestion</p> <p align="center">Local Plan review (2016 - 2036) 'Smaller Villages and Hamlets'</p>	<p>Scale 1:6,000</p> <p>Drawn by FB/PP</p>	<p>Date 04/08/2017</p> <p>Reference Number 008b</p>	<p>Legend</p> <p> Draft boundary suggestions reviewed</p> <p> First draft boundary suggestion</p>	<p>© Crown copyright and database rights 2017 Ordnance Survey 100024314</p>
---	---	--	---	--	---



Borough Council of King's Lynn & West Norfolk Tel. 01553 616200 Email: ldf@west-norfolk.gov.uk 	South Creake NORTH Evolved DRAFT Development Boundary Suggestion	Scale 1:4,000	Date 04/08/2017	Legend  Draft boundary suggestions reviewed  First draft boundary suggestion	© Crown copyright and database rights 2017 Ordnance Survey 100024314
	Local Plan review (2016 - 2036) 'Smaller Villages and Hamlets'	Drawn by FB/PP	Reference Number 009b_NORTH		



Borough Council of
King's Lynn & West Norfolk
 Tel. 01553 616200
 Email: ldf@west-norfolk.gov.uk



South Creake
Evolved DRAFT Development Boundary Suggestion

Local Plan review (2016 - 2036)
'Smaller Villages and Hamlets'



Scale
1:8,000

 Drawn by
FB/PP


Date
04/08/2017

 Reference Number
009b

Legend

-  Draft boundary suggestions reviewed
-  First draft boundary suggestion

© Crown copyright and
 database rights 2017
 Ordnance Survey 100024314

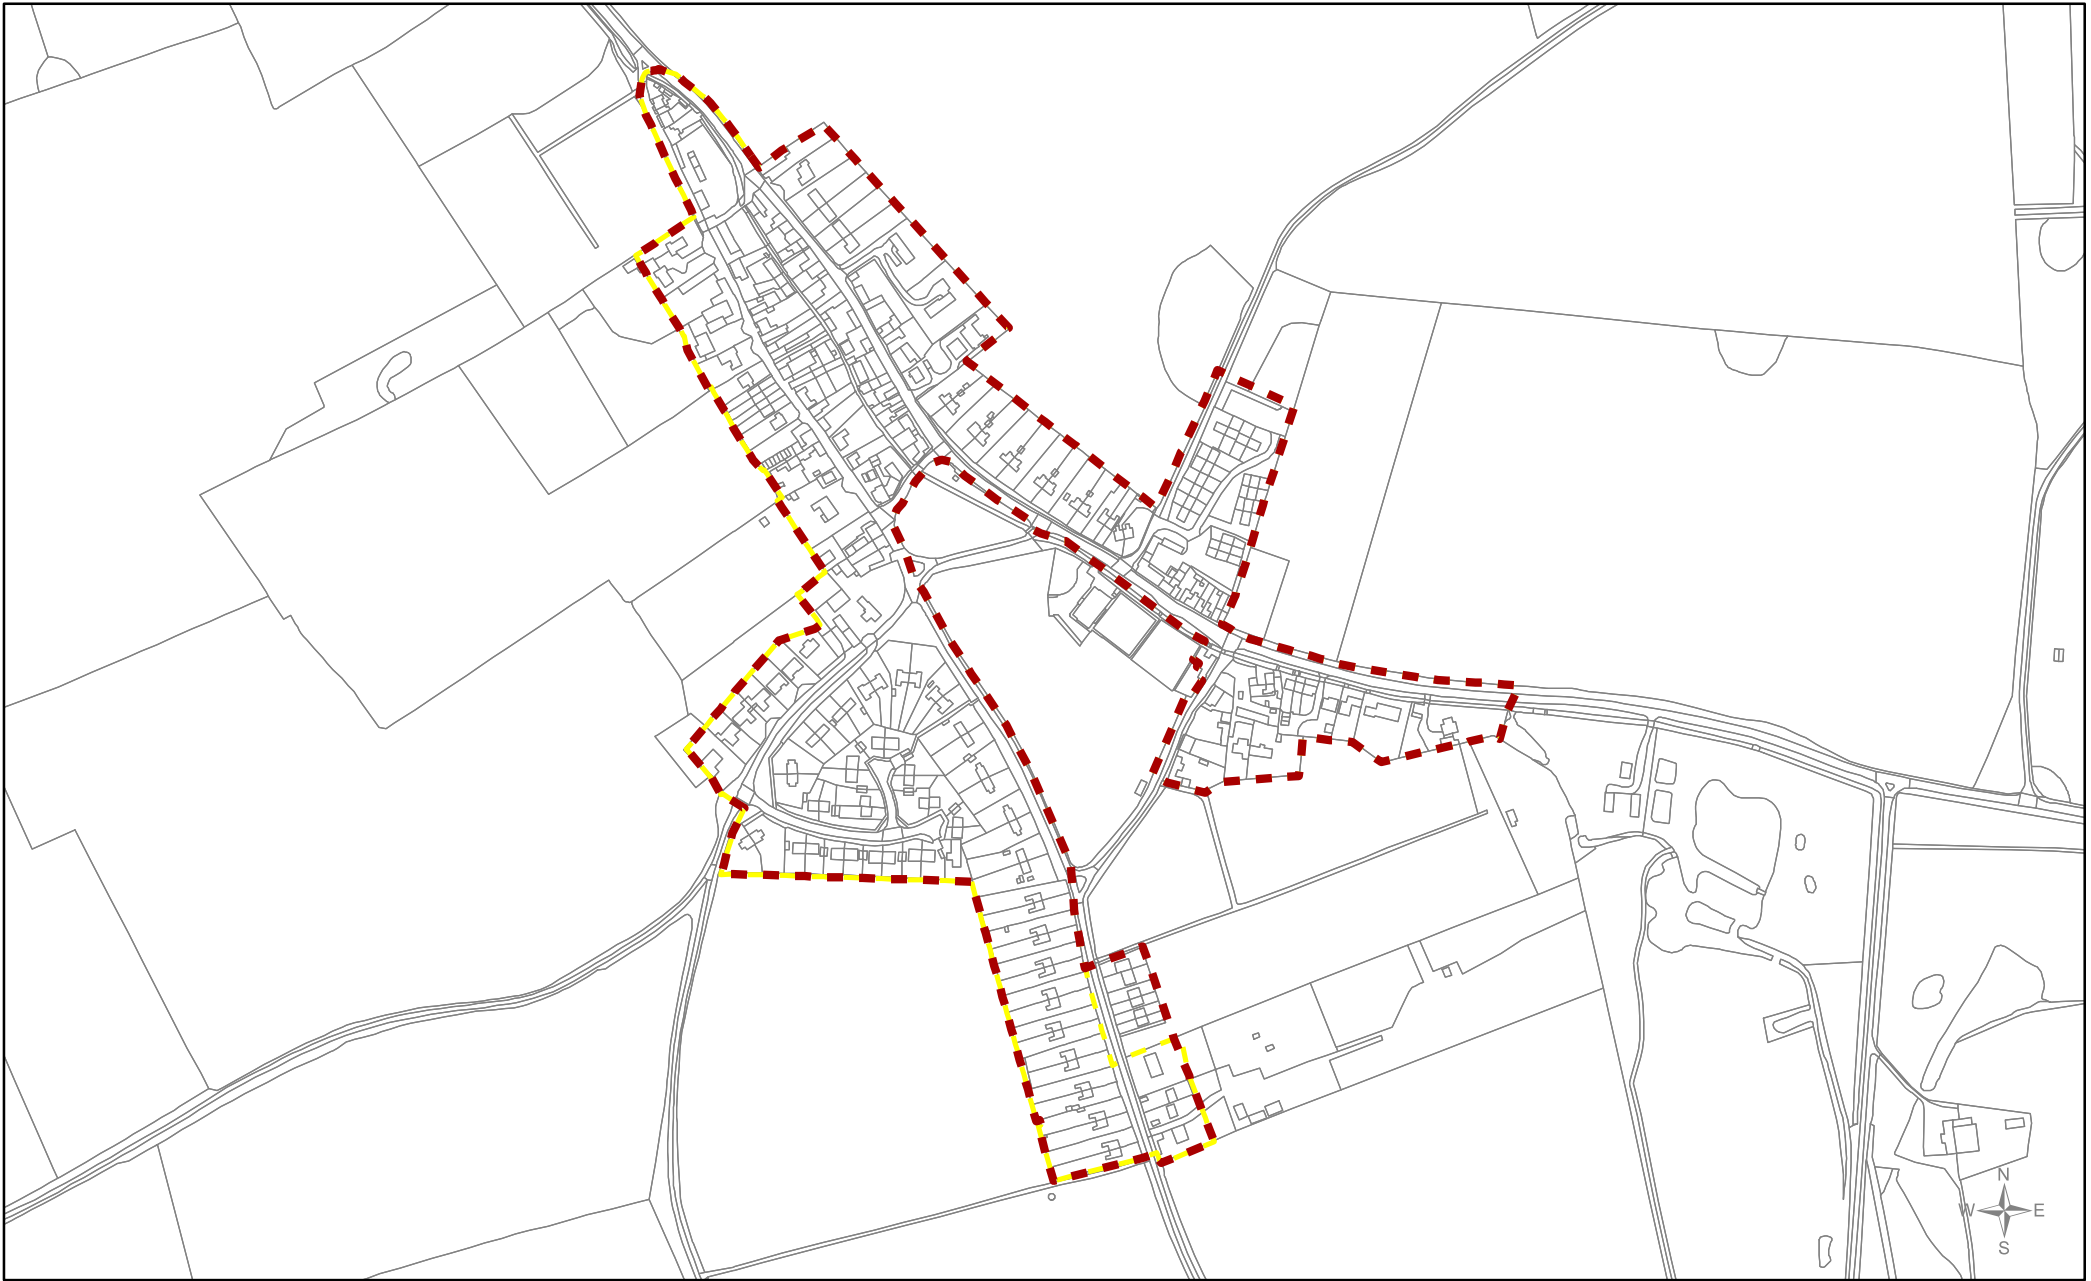

Borough Council of
**King's Lynn &
 West Norfolk**
 Tel. 01553 616200
 Email: ldf@west-norfolk.gov.uk



South Creake SOUTH
Evolved DRAFT Development Boundary Suggestion

Local Plan review (2016 - 2036)
'Smaller Villages and Hamlets'



Scale
1:5,000

 Drawn by
FB/PP


Date
04/08/2017


 Reference Number
009b_SOUTH


Legend

-  Draft boundary suggestions reviewed
-  First draft boundary suggestion

© Crown copyright and
 database rights 2017
 Ordnance Survey 100024314

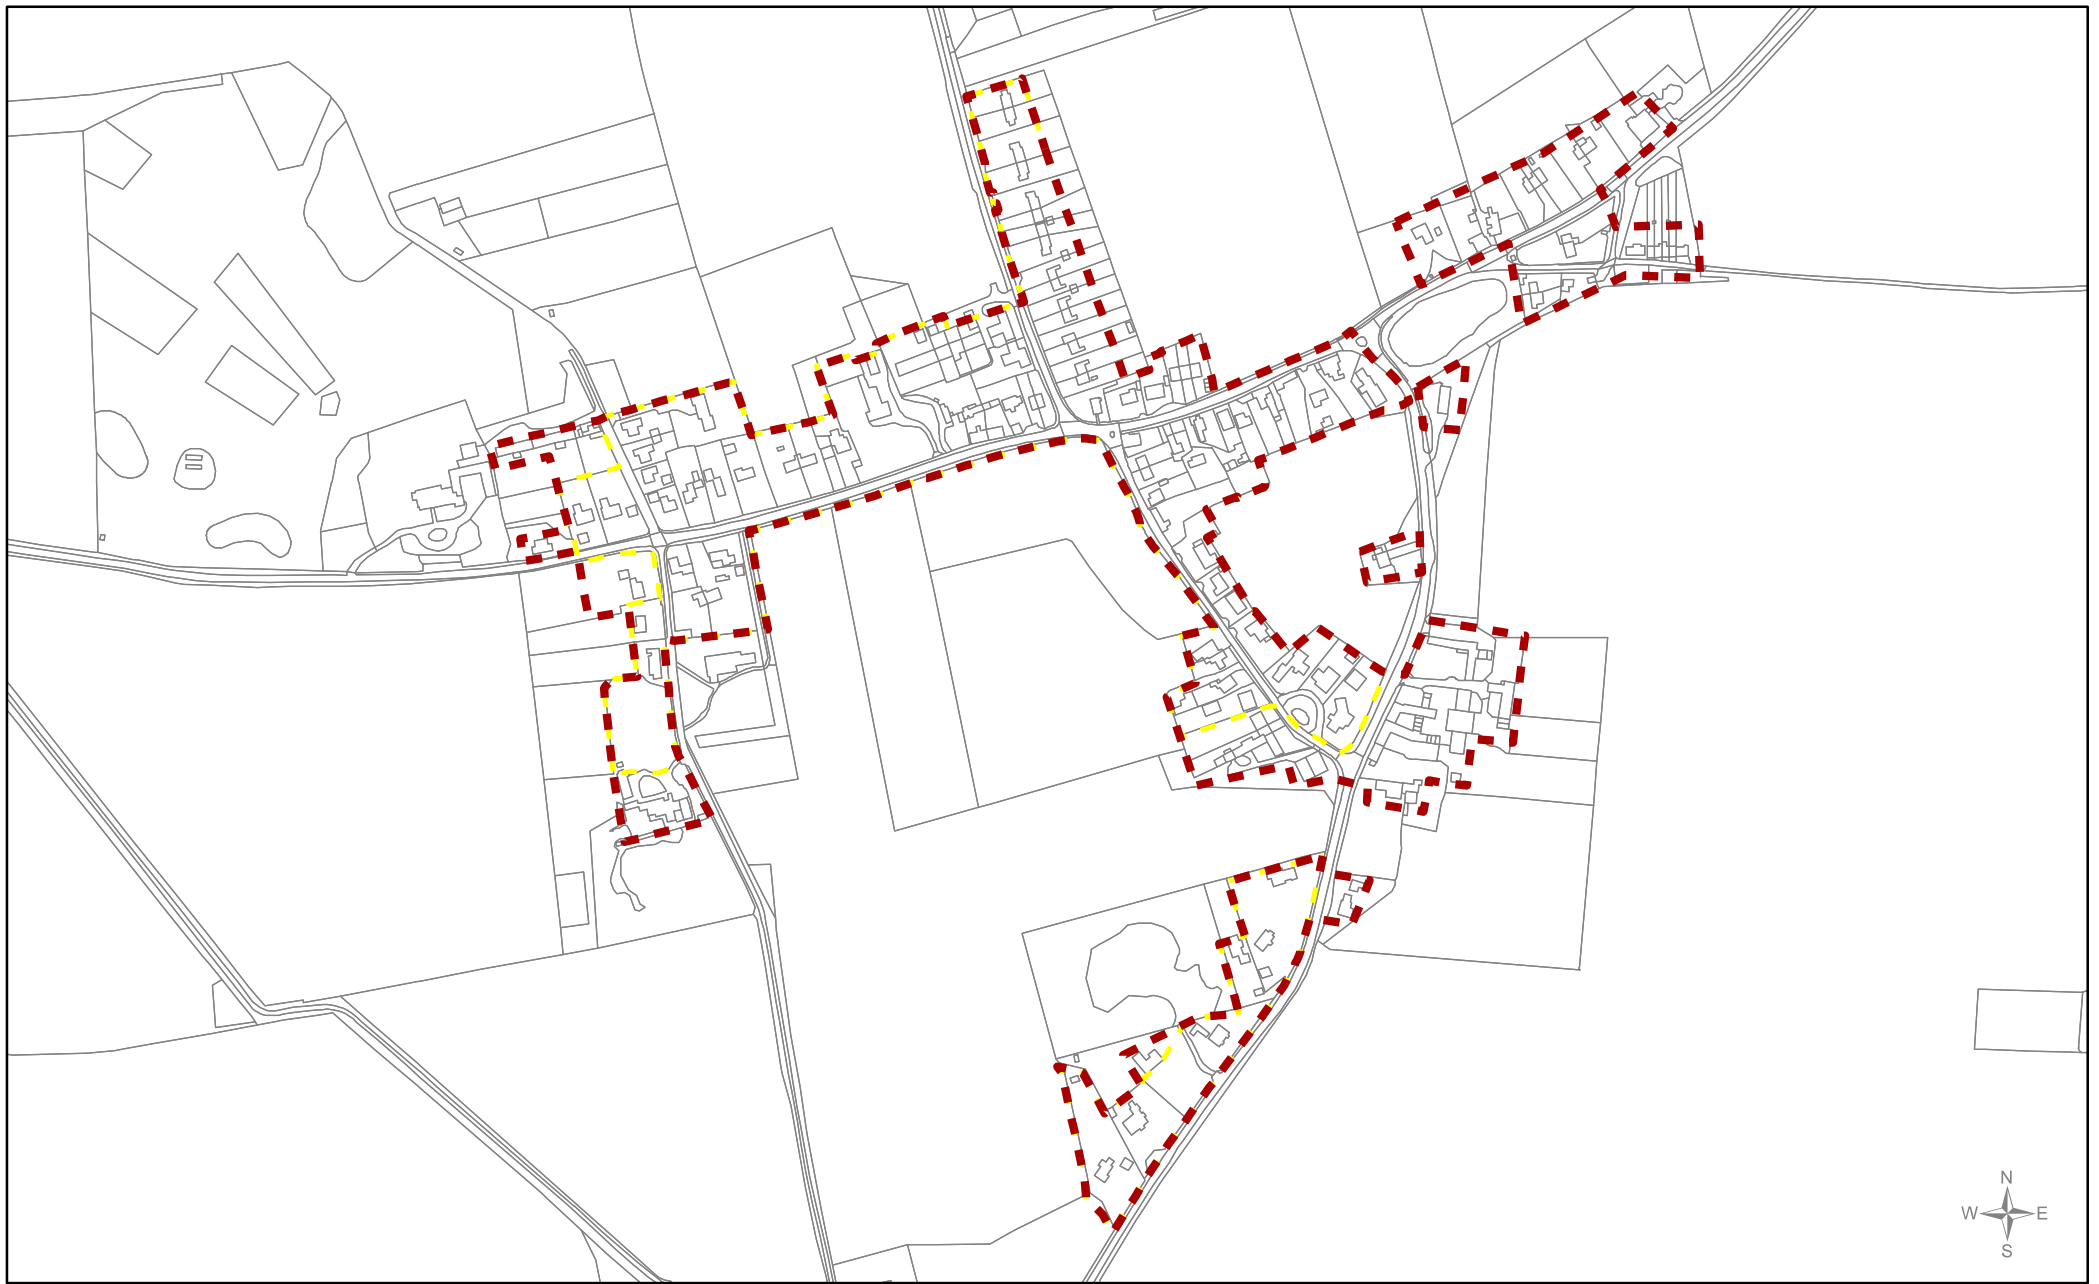

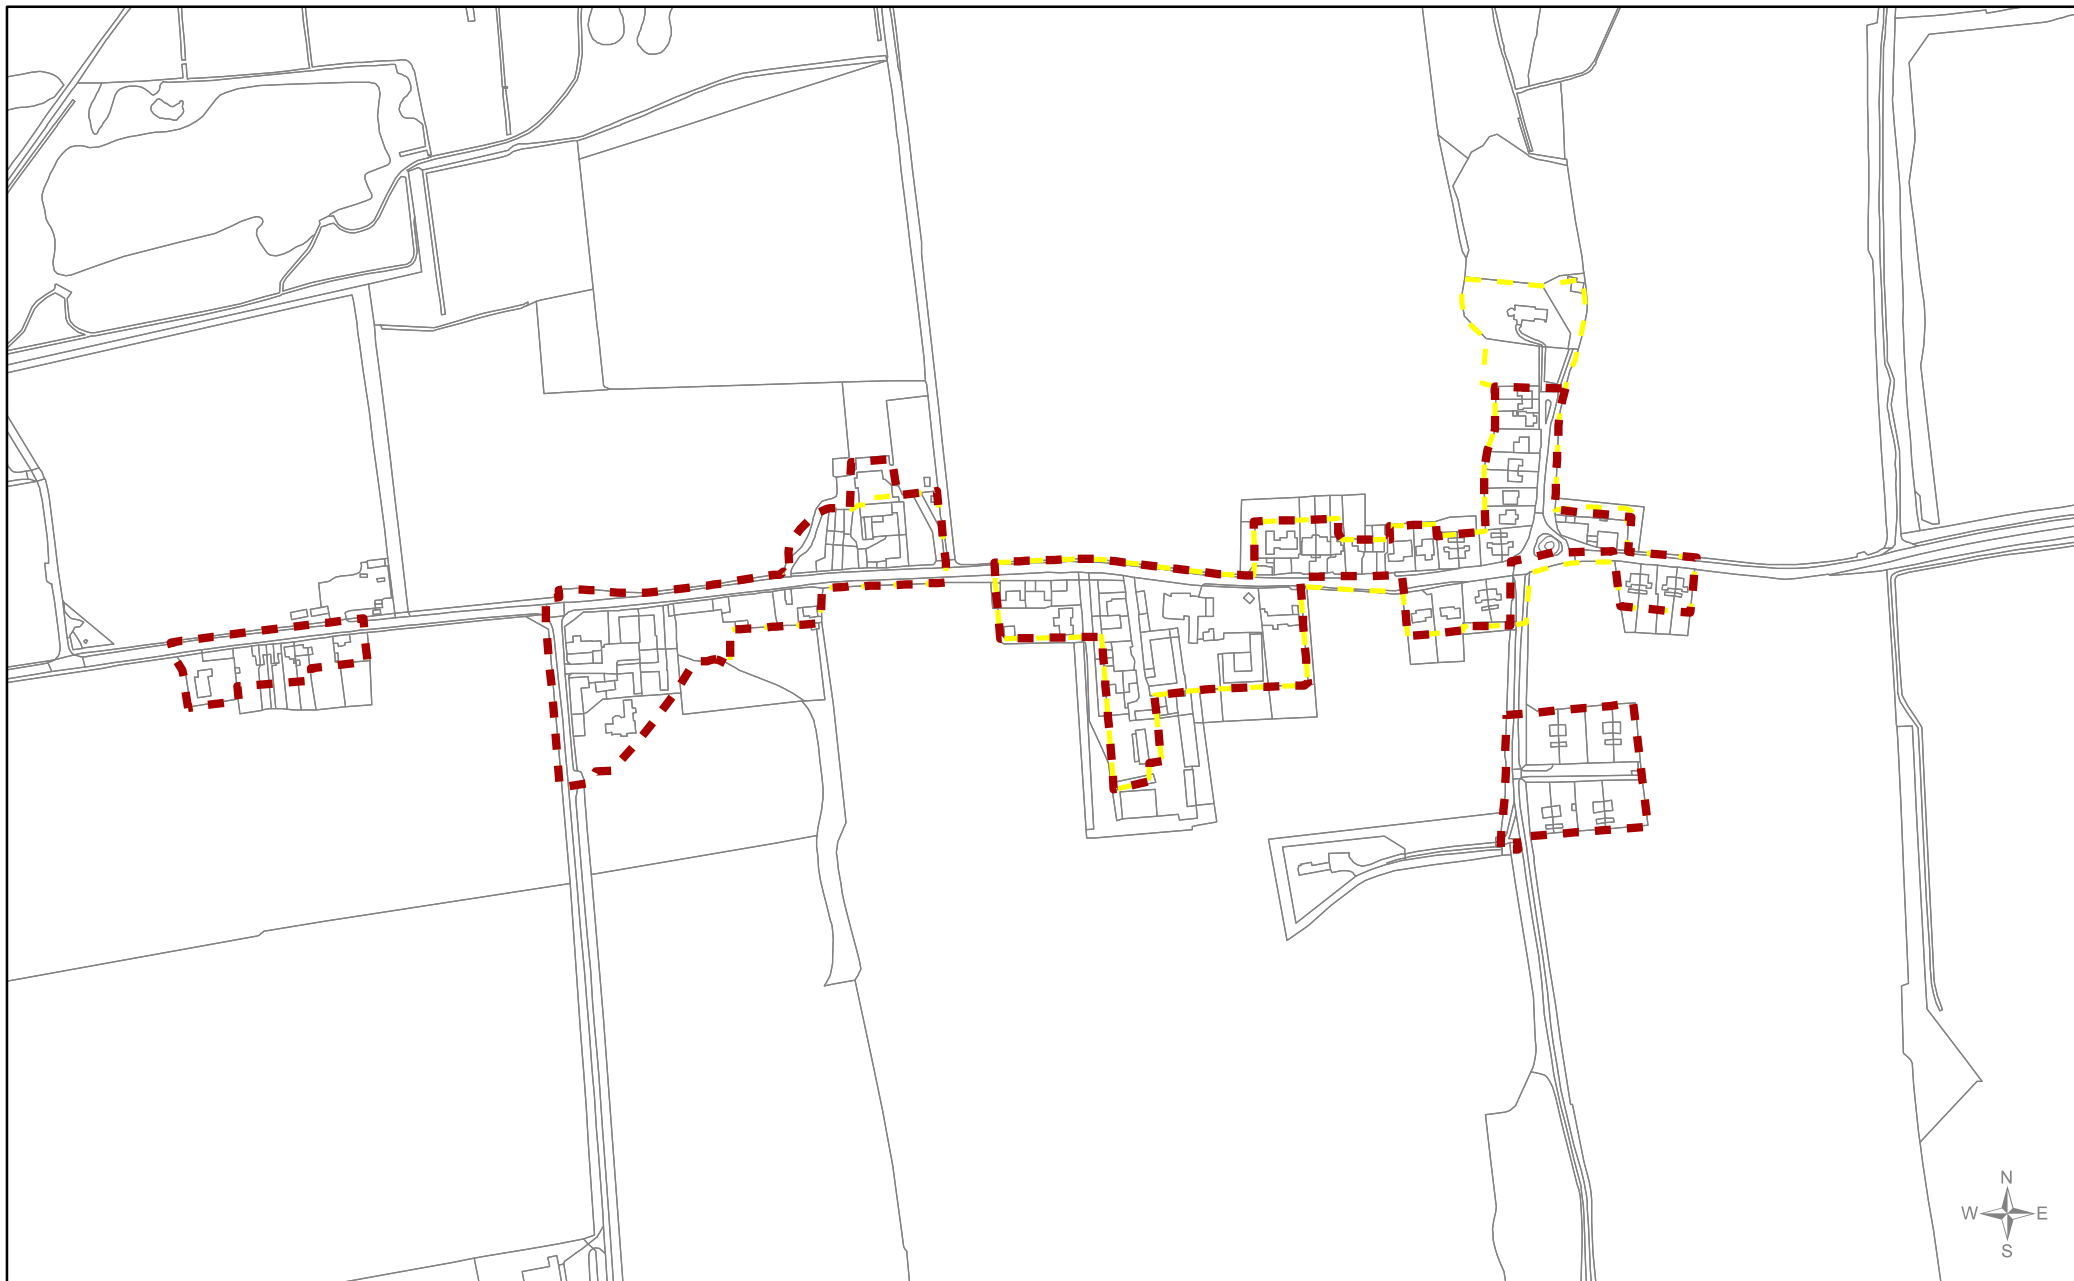

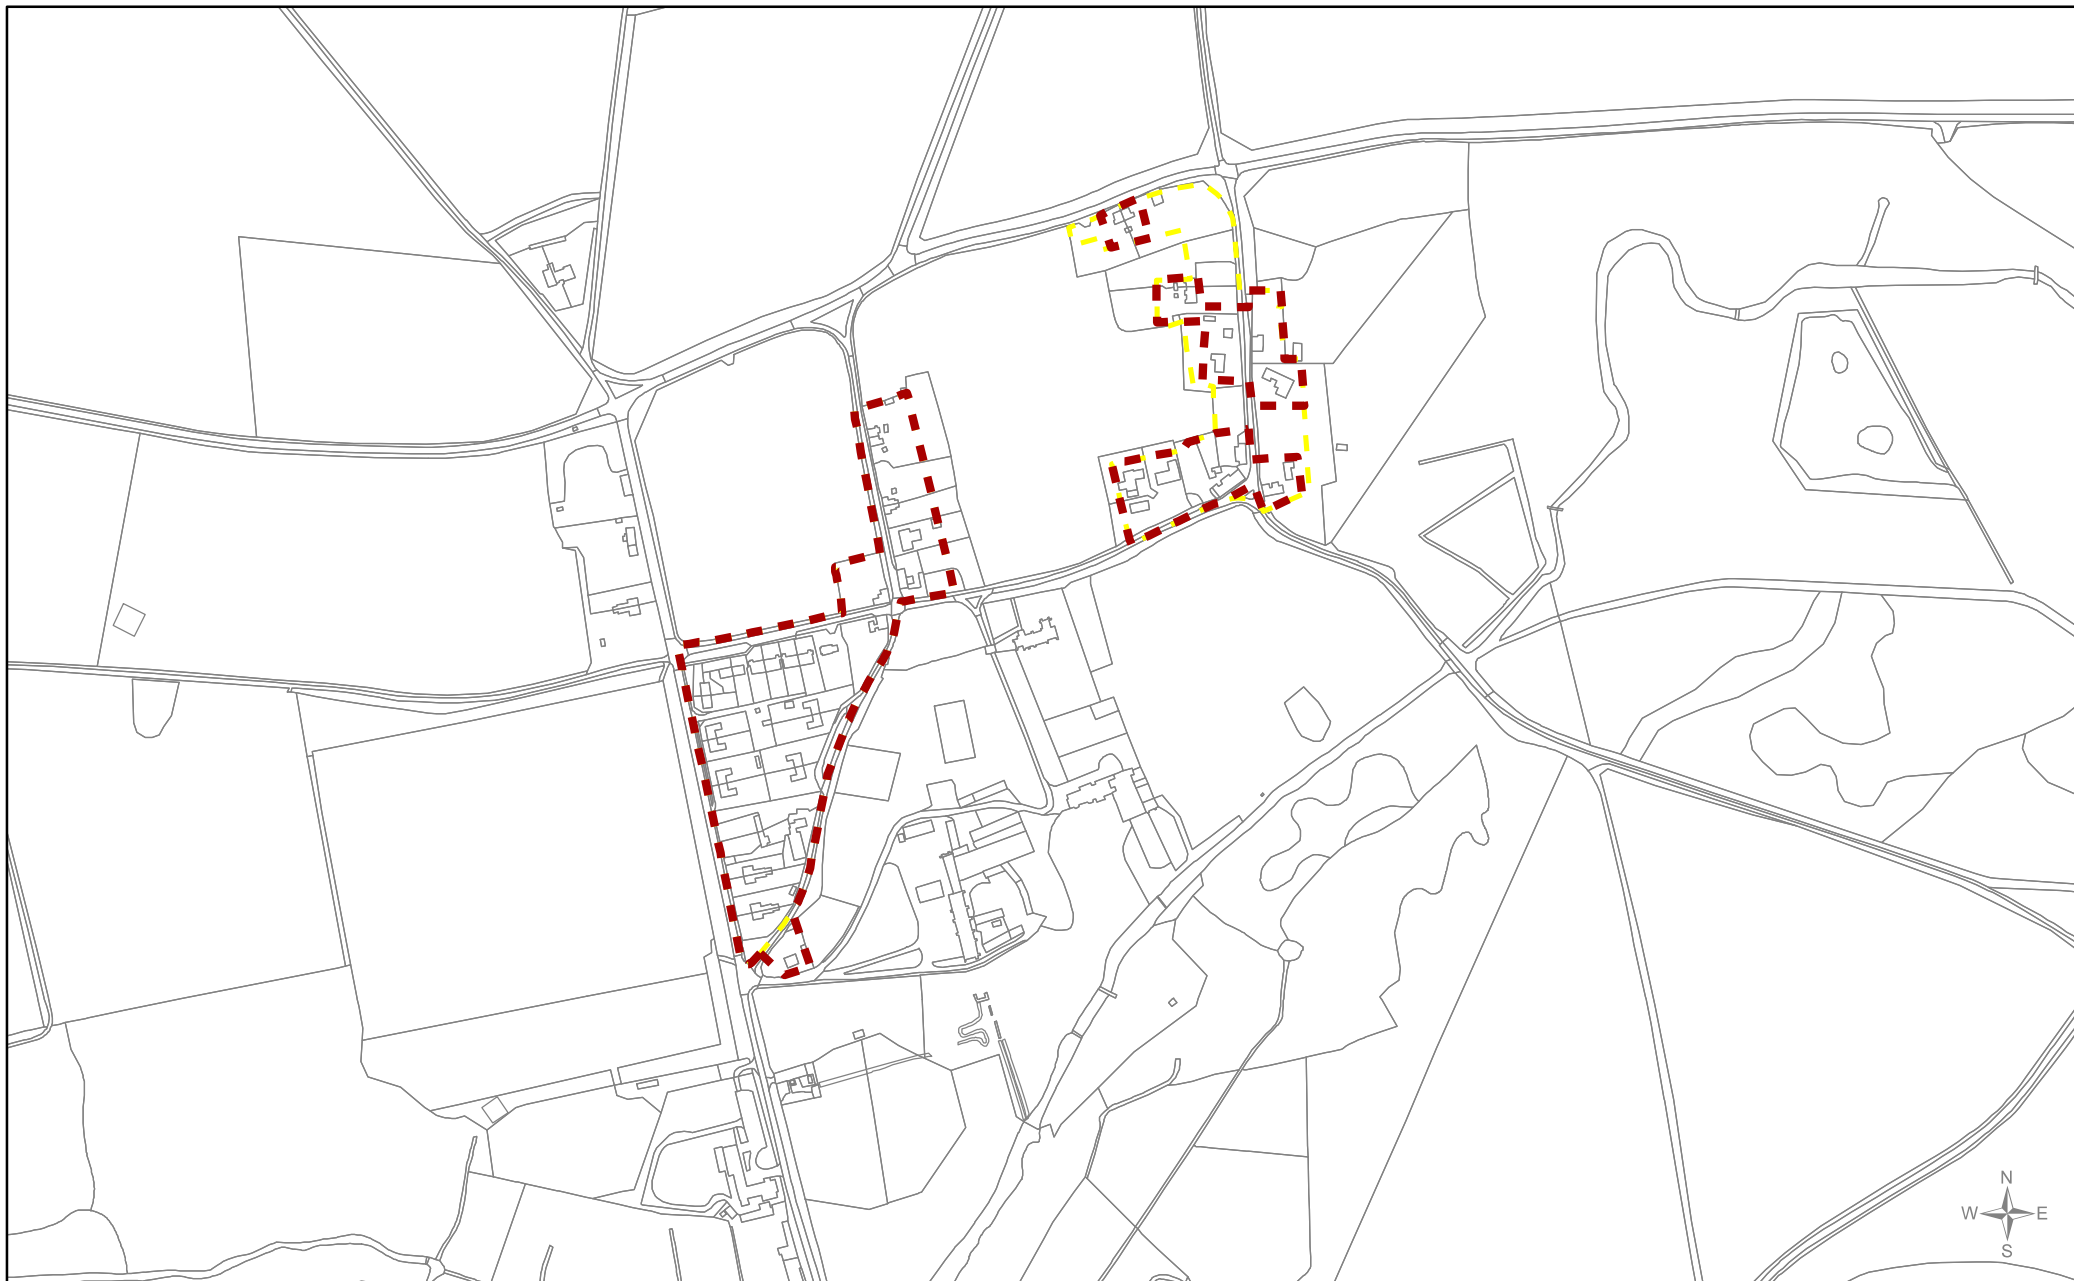

Borough Council of
**King's Lynn &
 West Norfolk**
 Tel. 01553 616200
 Email: ldf@west-norfolk.gov.uk



West Acre
Evolved DRAFT Development Boundary Suggestion



Local Plan review (2016 - 2036)
'Smaller Villages and Hamlets'

Scale
1:5,000


 Drawn by
FB/PP


Date
04/08/2017

 Reference Number
012b

Legend
 Draft boundary suggestions reviewed
 First draft boundary suggestion

© Crown copyright and
 database rights 2017
 Ordnance Survey 100024314

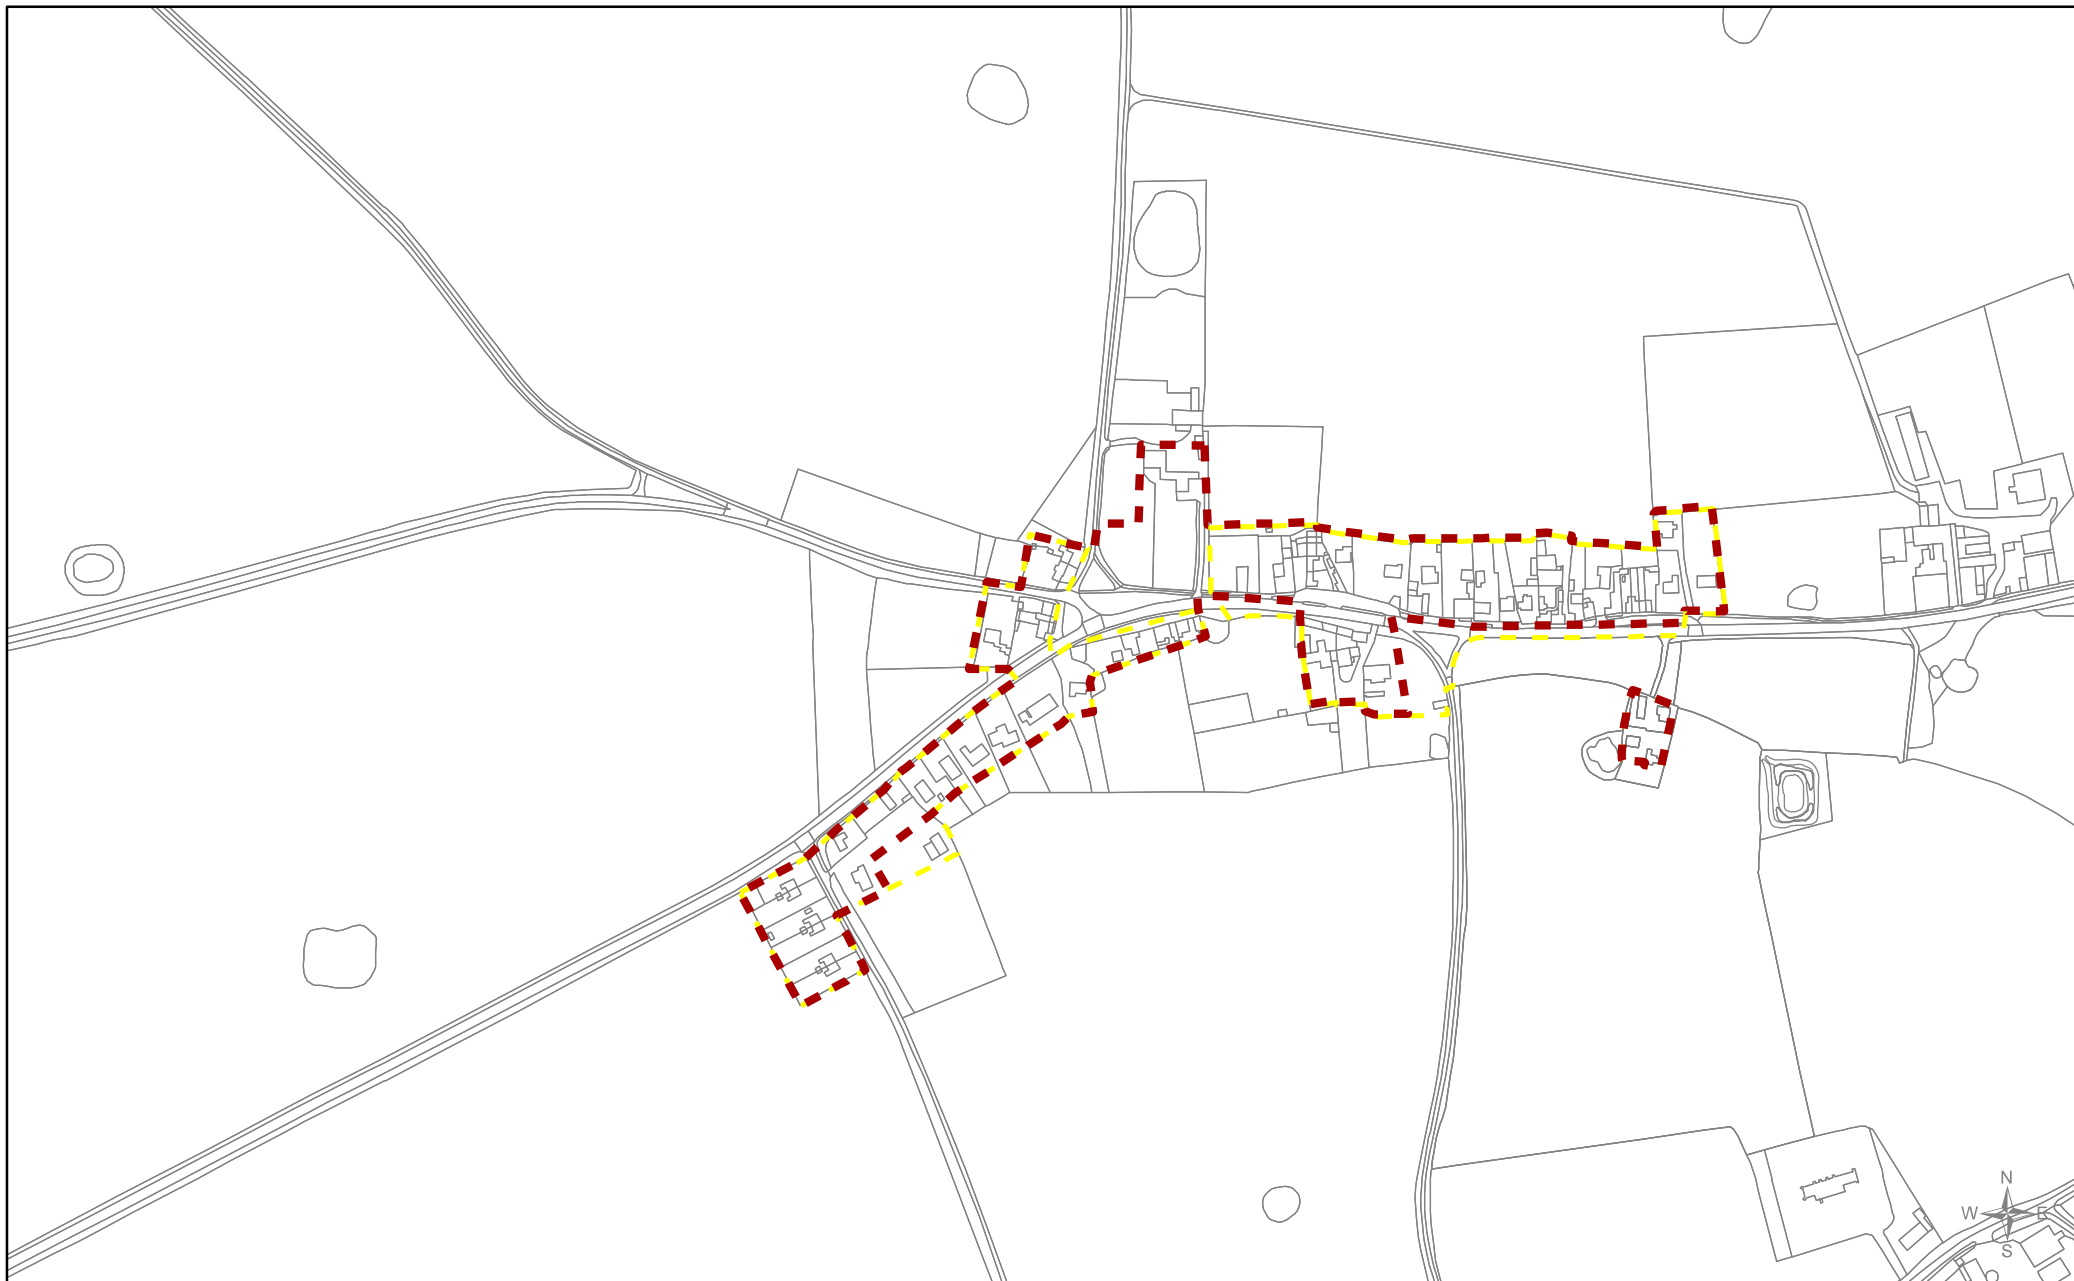

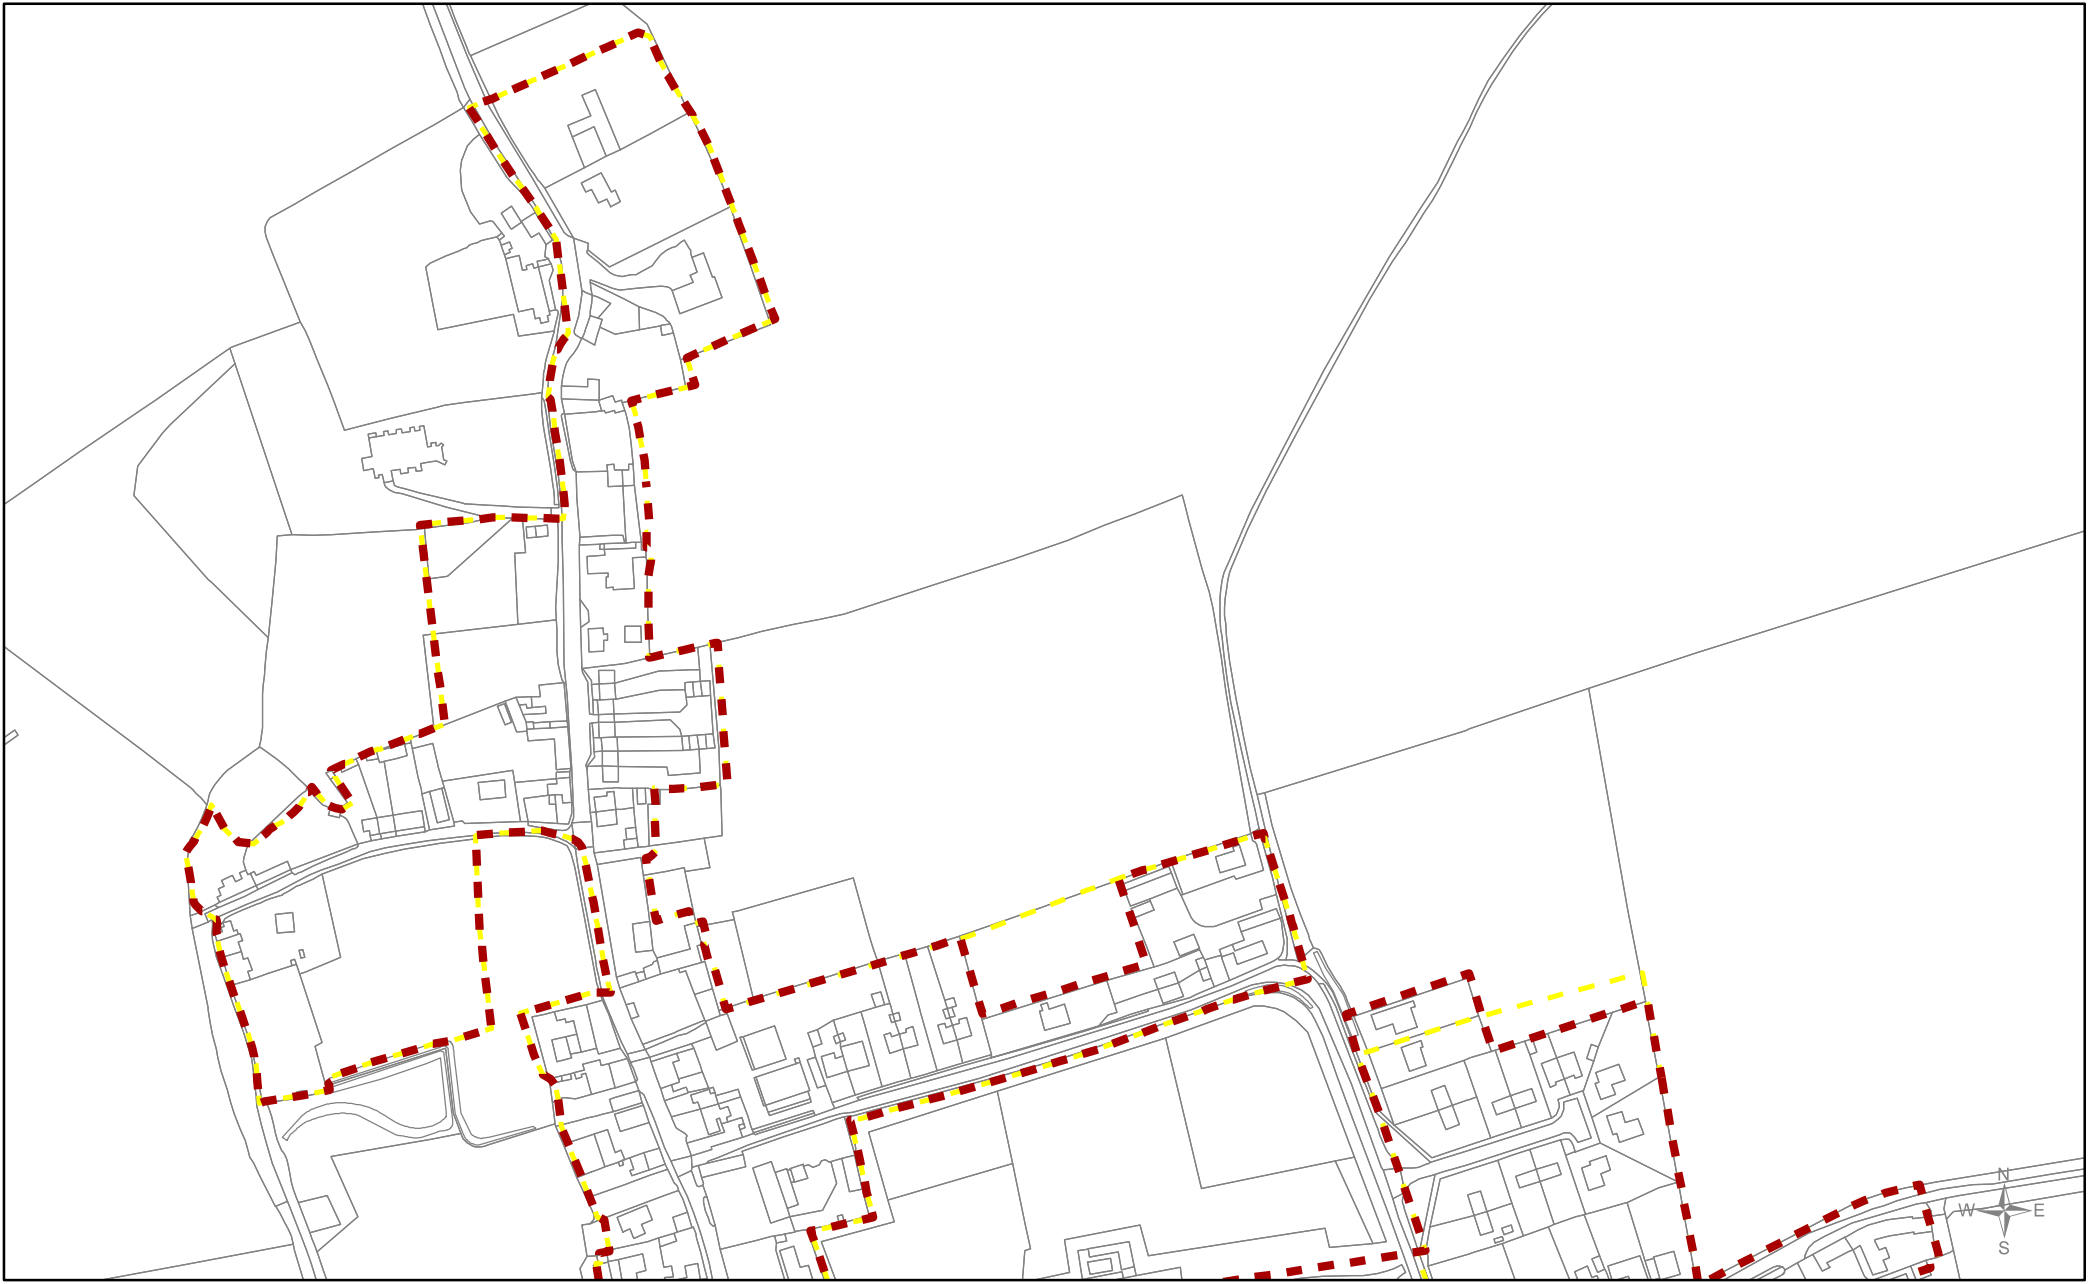

Borough Council of
**King's Lynn &
 West Norfolk**
 Tel. 01553 616200
 Email: ldf@west-norfolk.gov.uk



Ringstead CENTRE
Evolved DRAFT Development Boundary Suggestion



Local Plan review (2016 - 2036)
'Smaller Villages and Hamlets'

Scale
1:3,000

 Drawn by
FB/PP




Date
04/08/2017


 Reference Number
014b CENTRE


Legend
 Draft boundary suggestions reviewed
 First draft boundary suggestion

© Crown copyright and
 database rights 2017
 Ordnance Survey 100024314



Borough Council of King's Lynn & West Norfolk Tel. 01553 616200 Email: ldf@west-norfolk.gov.uk 	Ringstead NORTH Evolved DRAFT Development Boundary Suggestion	Scale 1:4,000	Date 04/08/2017	Legend  Draft boundary suggestions reviewed  First draft boundary suggestion	<small>© Crown copyright and database rights 2017 Ordnance Survey 100024314</small>
	Local Plan review (2016 - 2036) 'Smaller Villages and Hamlets'	Drawn by FB/PP	Reference Number 014b_NORTH		

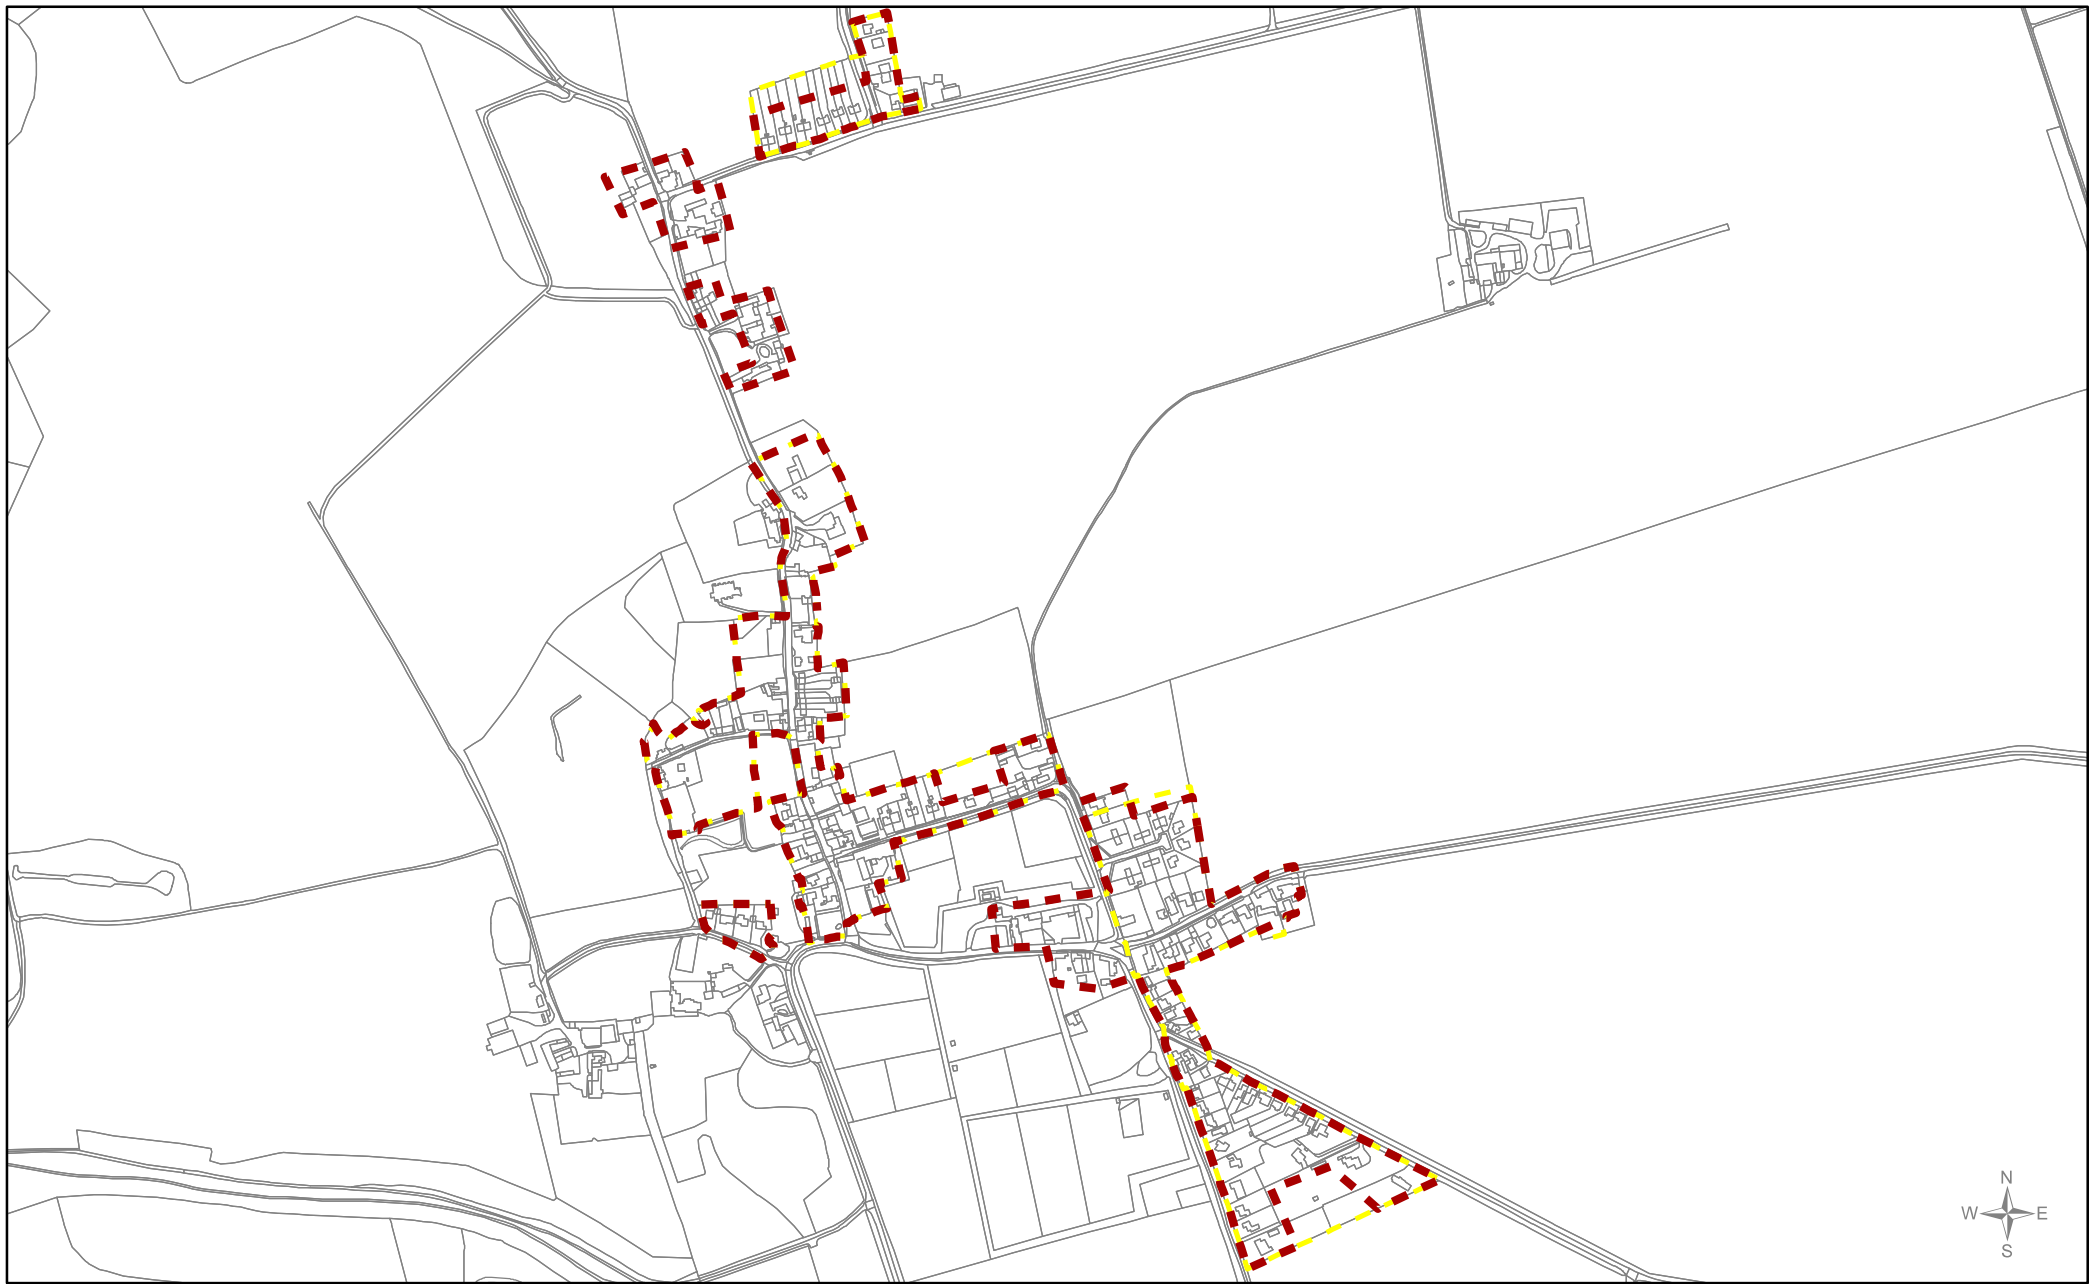

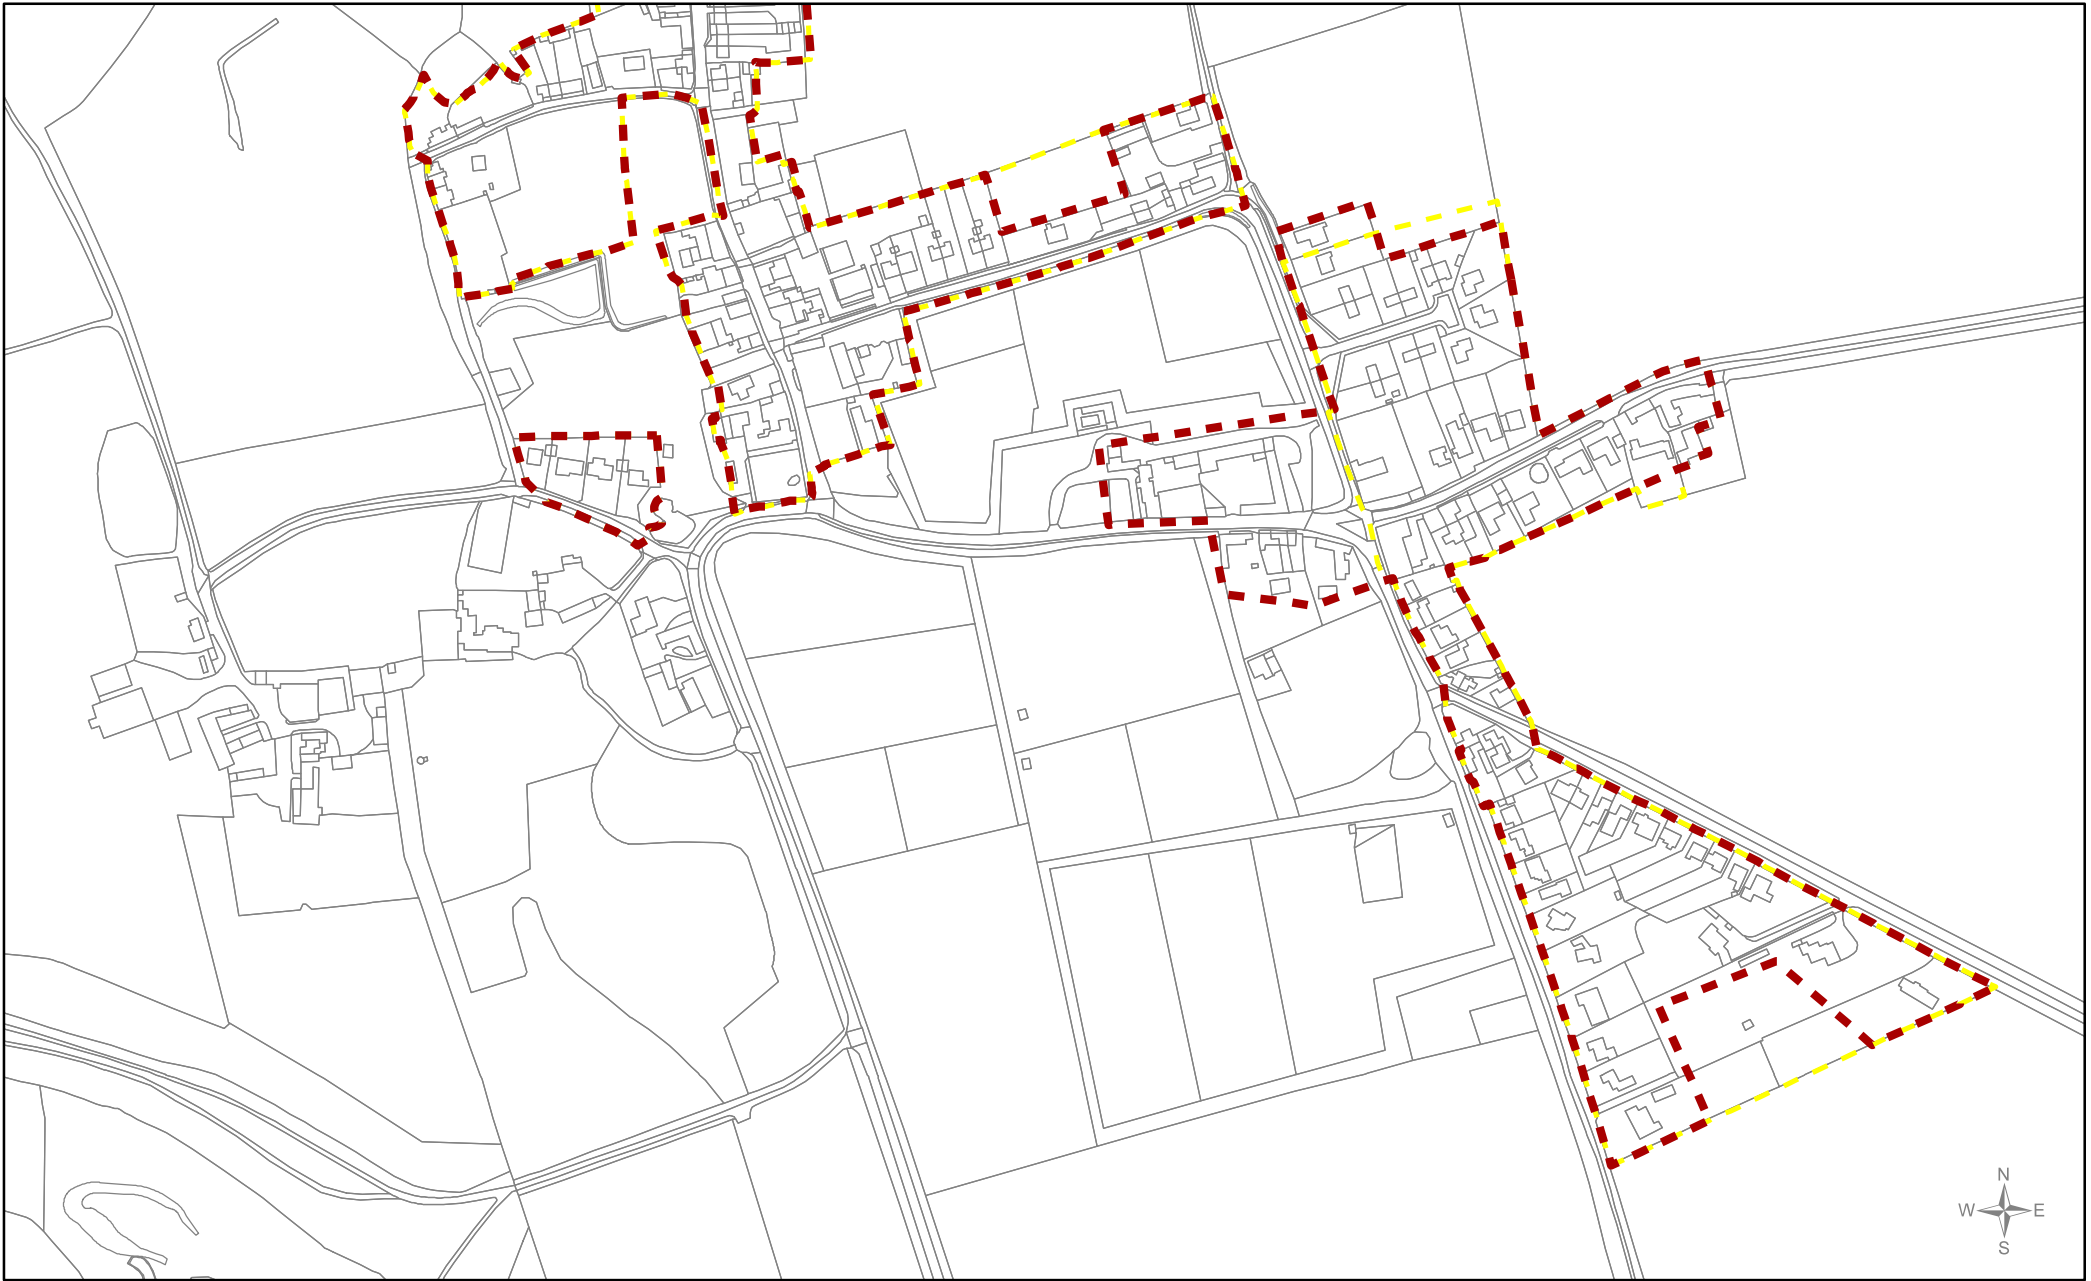

Borough Council of
King's Lynn & West Norfolk
 Tel. 01553 616200
 Email: ldf@west-norfolk.gov.uk



Ringstead SOUTH
 Evolved DRAFT Development Boundary Suggestion

Local Plan review (2016 - 2036)
 'Smaller Villages and Hamlets'



Scale
1:4,000

Drawn by
FB/PP

Date
04/08/2017

Reference Number
014b_SOUTH

Legend

-  Draft boundary suggestions reviewed
-  First draft boundary suggestion

© Crown copyright and database rights 2017
 Ordnance Survey 100024314