



**Local Plan Task Group**  
**Wednesday, 13th September, 2017 at 10.00 am**  
**in the Education Room - Town Hall, Saturday Market**  
**Place, King's Lynn PE30 5DQ**

**Reports marked to follow on the Agenda and/or Supplementary Documents**

1. **Looking at the SVAH's in the South of the Borough - MAPS TO FOLLOW** (Pages 2 - 25)

**Contact**

Democratic Services  
Borough Council of King's Lynn and West Norfolk  
King's Court  
Chapel Street  
King's Lynn  
Norfolk  
PE30 1EX  
Tel: 01553 616394  
Email: [democratic.services@west-norfolk.gov.uk](mailto:democratic.services@west-norfolk.gov.uk)



2



Borough Council of  
**King's Lynn & West Norfolk**  
 Tel. 01553 616200  
 Email: [ldf@west-norfolk.gov.uk](mailto:ldf@west-norfolk.gov.uk)



**Barroway Drove**  
 Evolved DRAFT Development Boundary Suggestion

**Local Plan review (2016 - 2036)**  
 'Smaller Villages and Hamlets'



Scale  
**1:10,000**

Drawn by  
**FB/PP**


Date  
**07/09/2017**


Reference Number  
**016b**


**Legend**

-  Draft boundary suggestions reviewed
-  First draft boundary suggestion

© Crown copyright and database rights 2017  
 Ordnance Survey 100024314

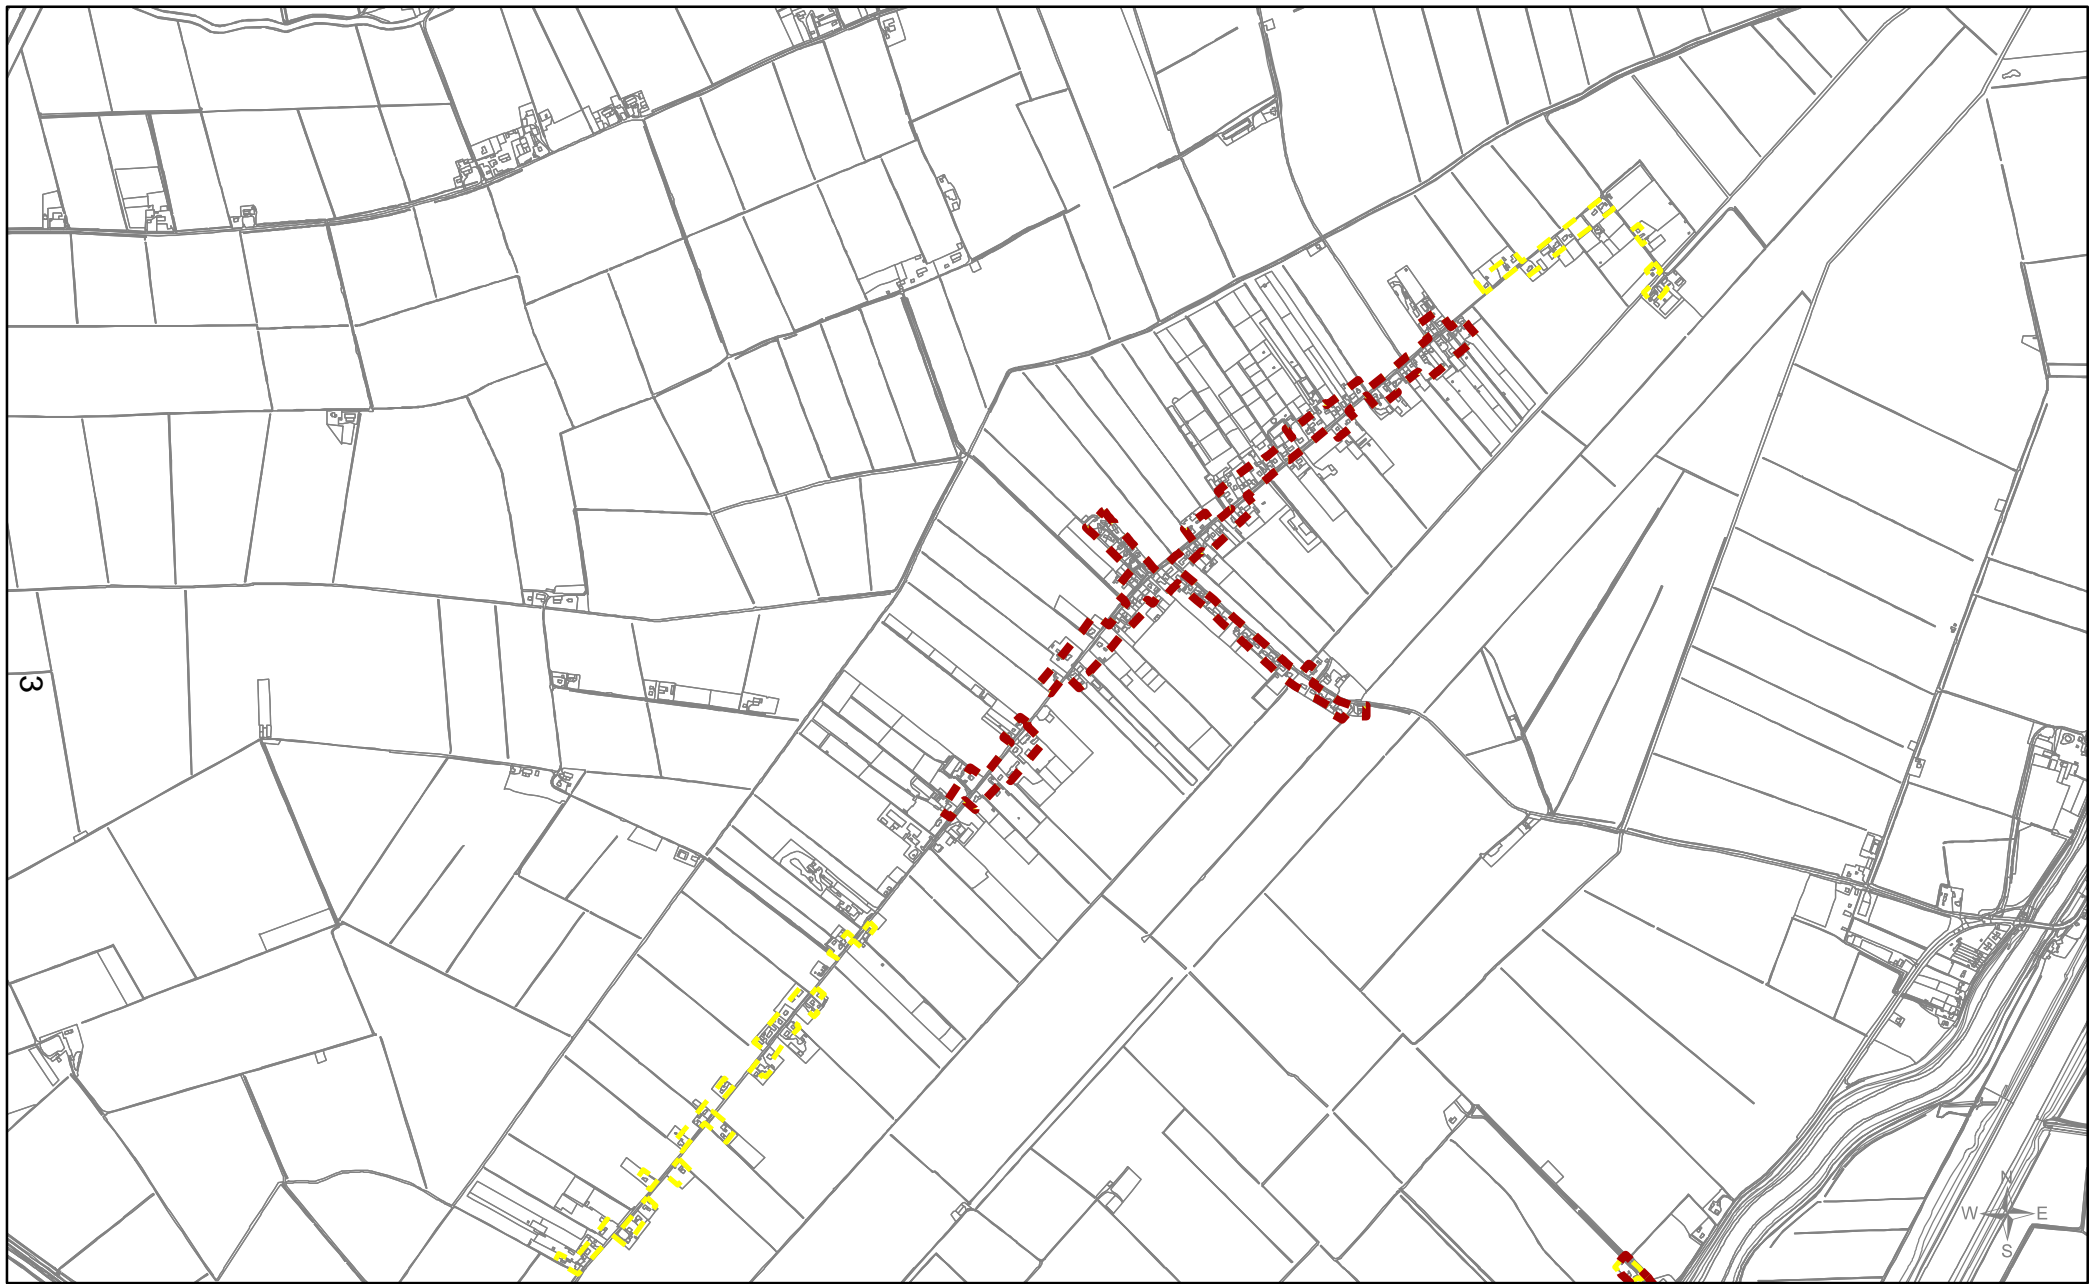

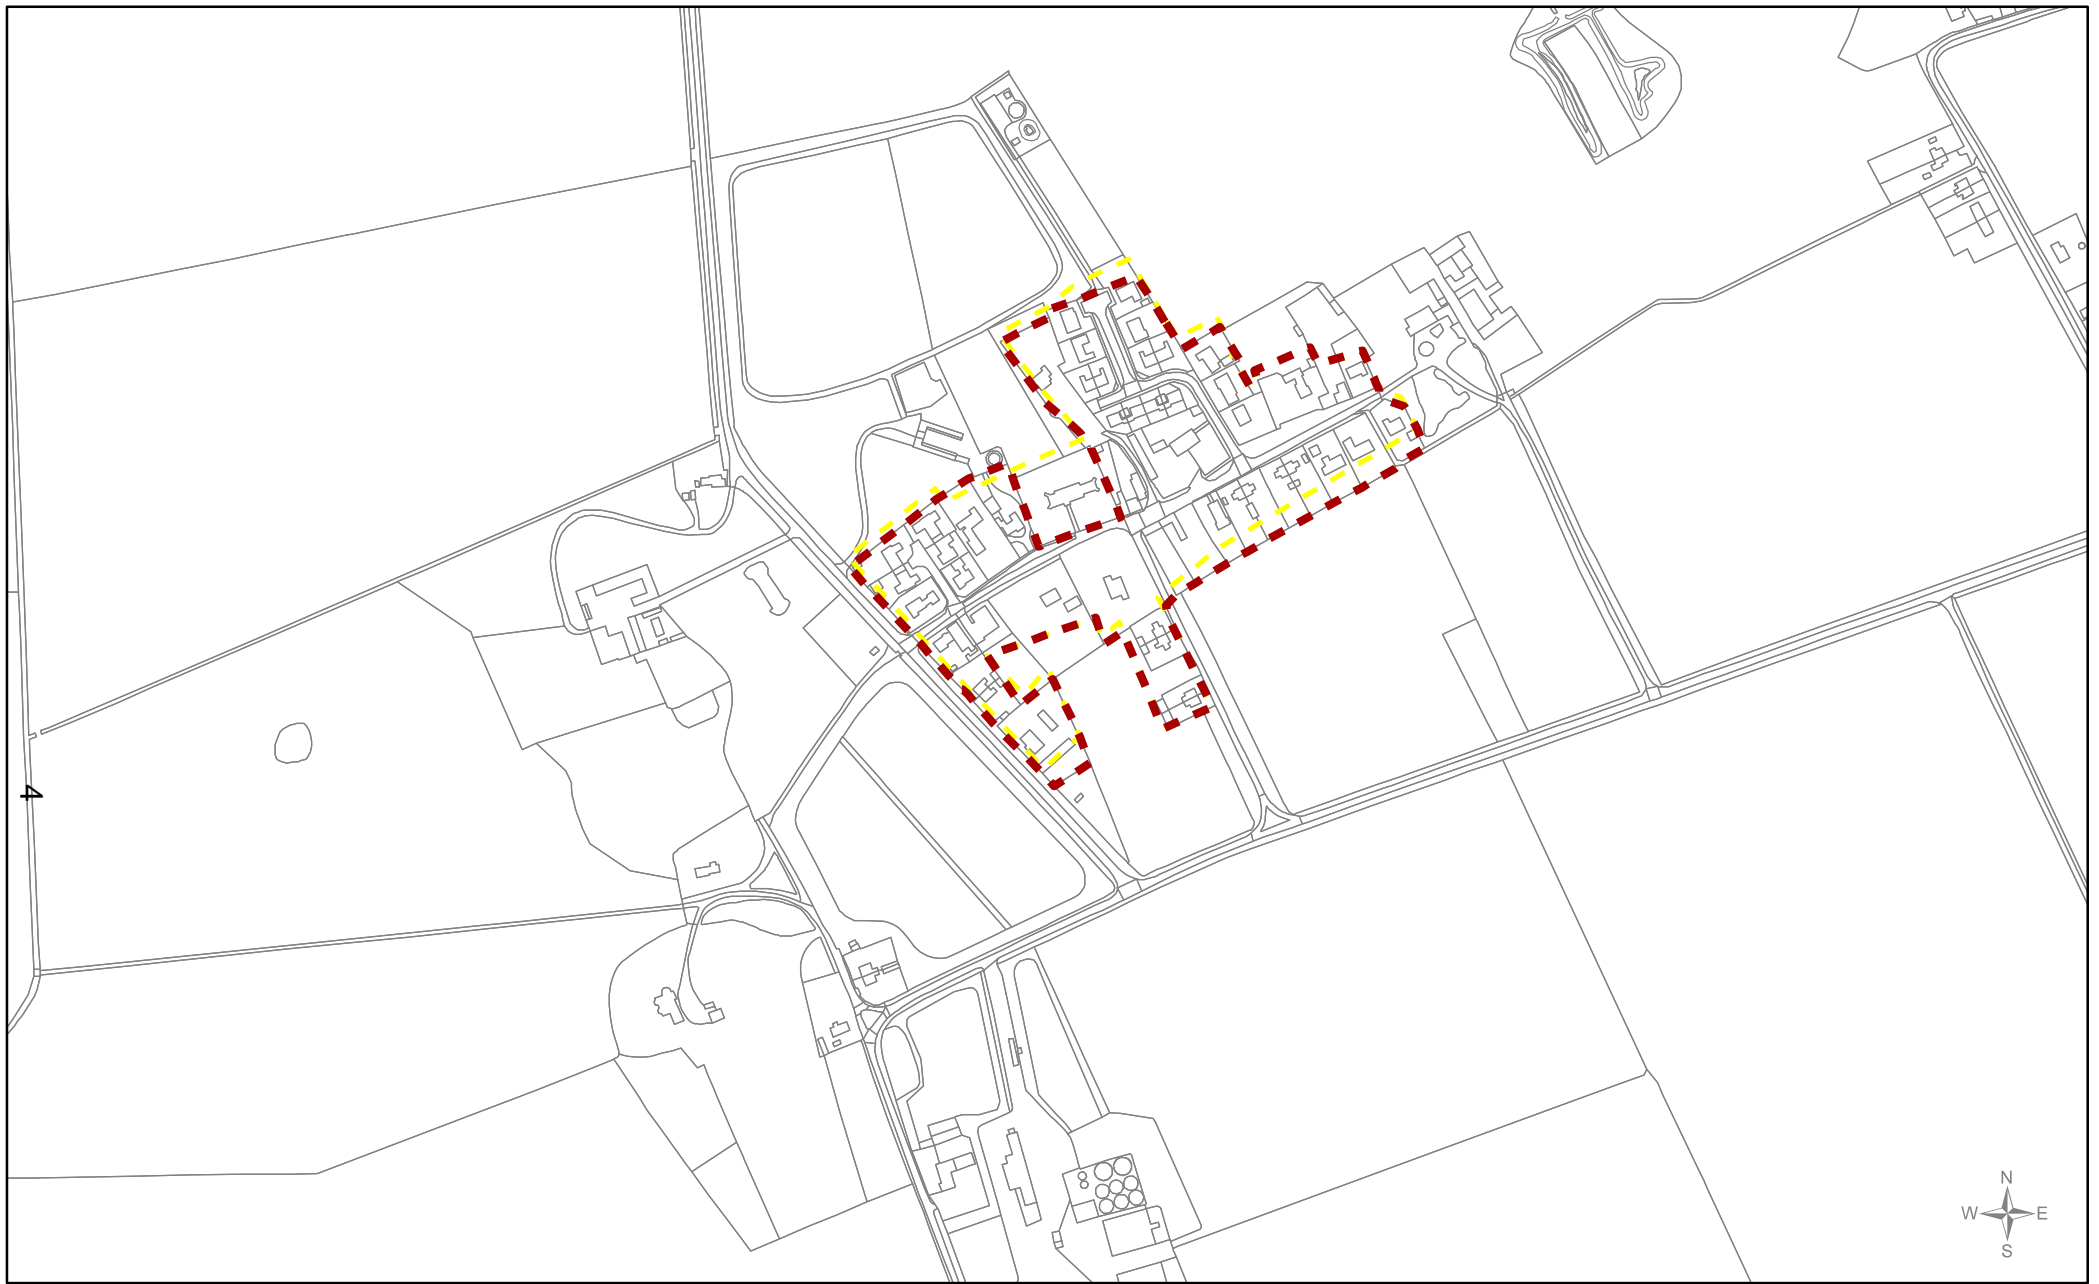

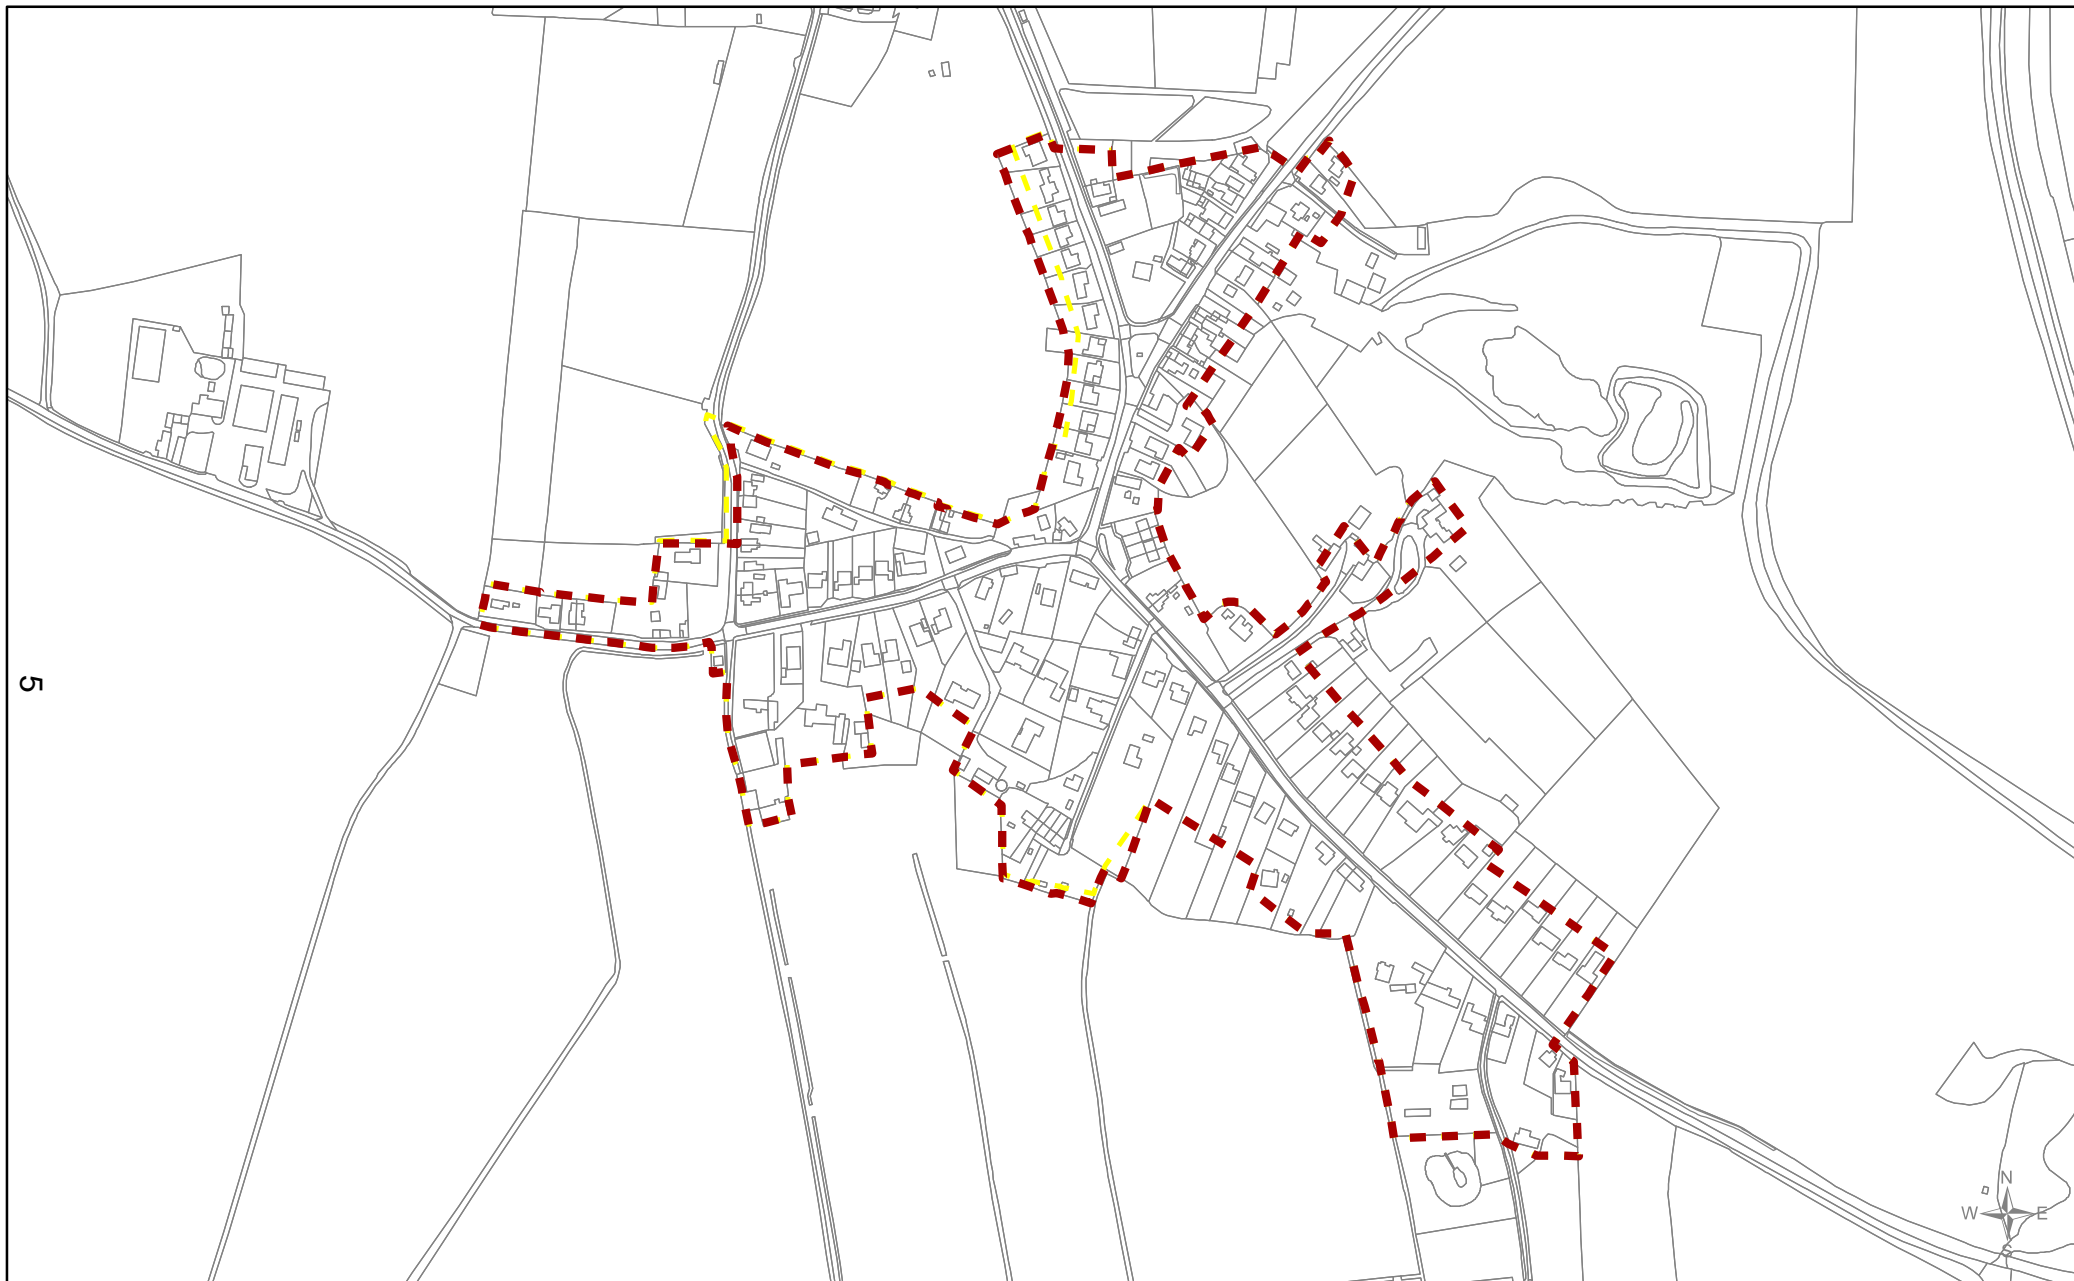

5



Borough Council of  
**King's Lynn &  
 West Norfolk**  
 Tel. 01553 616200  
 Email: [ldf@west-norfolk.gov.uk](mailto:ldf@west-norfolk.gov.uk)



**Blackborough End**  
 Evolved DRAFT Development Boundary Suggestion

**Local Plan review (2016 - 2036)**  
 'Smaller Villages and Hamlets'



Scale  
**1:5,000**

Drawn by  
**FB/PP**

Date  
**07/09/2017**


Reference Number  
**018b**

**Legend**

-  Draft boundary suggestions reviewed
-  First draft boundary suggestion

© Crown copyright and  
 database rights 2017  
 Ordnance Survey 100024314



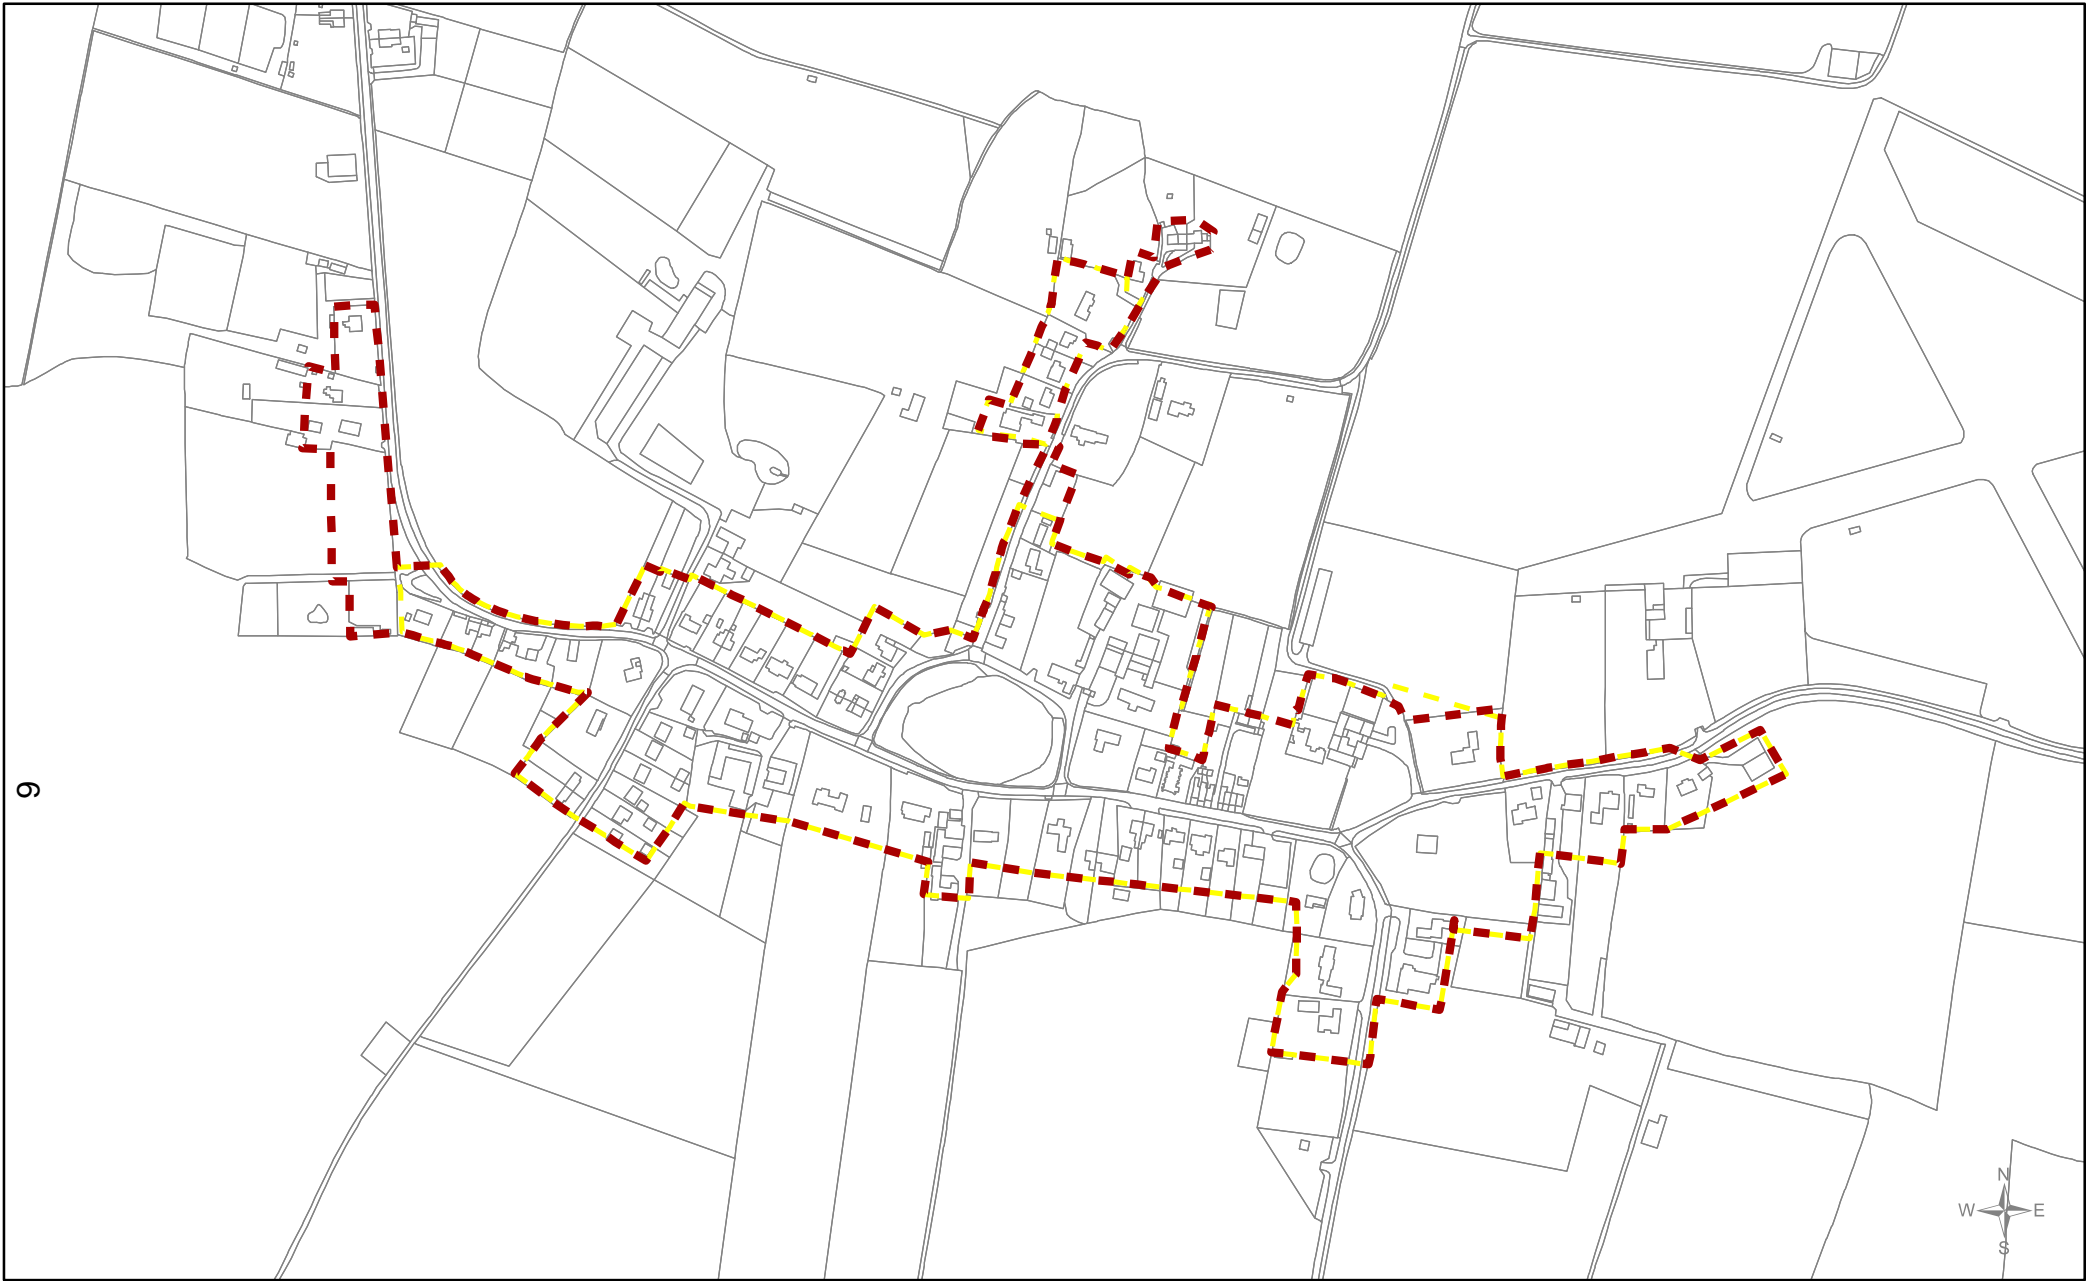

9



Borough Council of  
**King's Lynn &  
 West Norfolk**  
 Tel. 01553 616200  
 Email: [ldf@west-norfolk.gov.uk](mailto:ldf@west-norfolk.gov.uk)



**Boughton**  
 Evolved DRAFT Development Boundary Suggestion

---

Local Plan review (2016 - 2036)  
 'Smaller Villages and Hamlets'

Scale  
**1:5,000**

---



Drawn by  
**FB/PP**

Date  
**07/09/2017**


---


Reference Number  
**019b**

**Legend**

-  Draft boundary suggestions reviewed
-  First draft boundary suggestion

© Crown copyright and  
 database rights 2017  
 Ordnance Survey 100024314

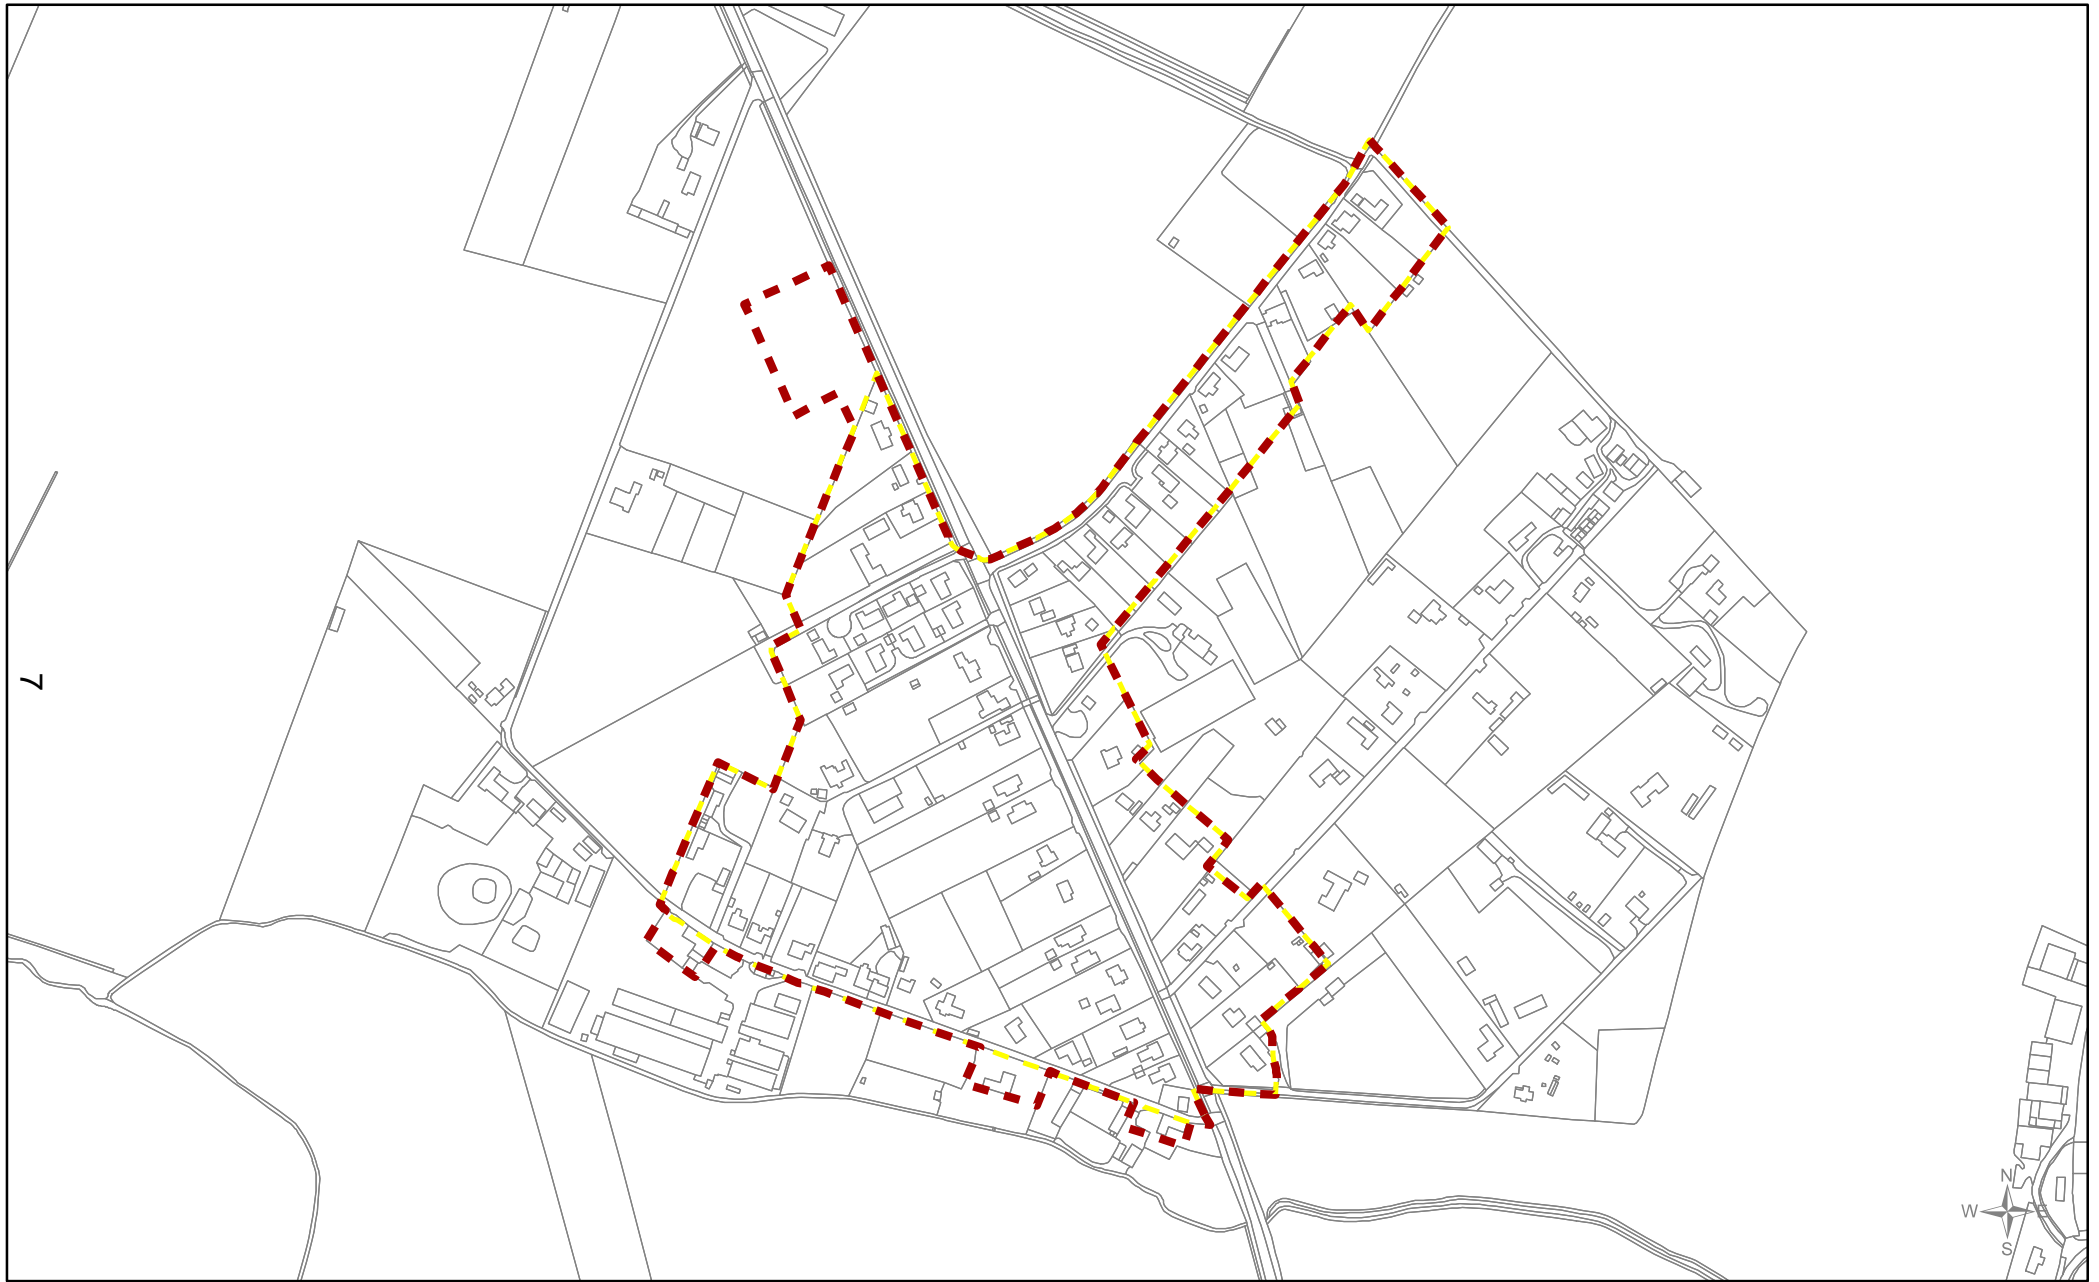

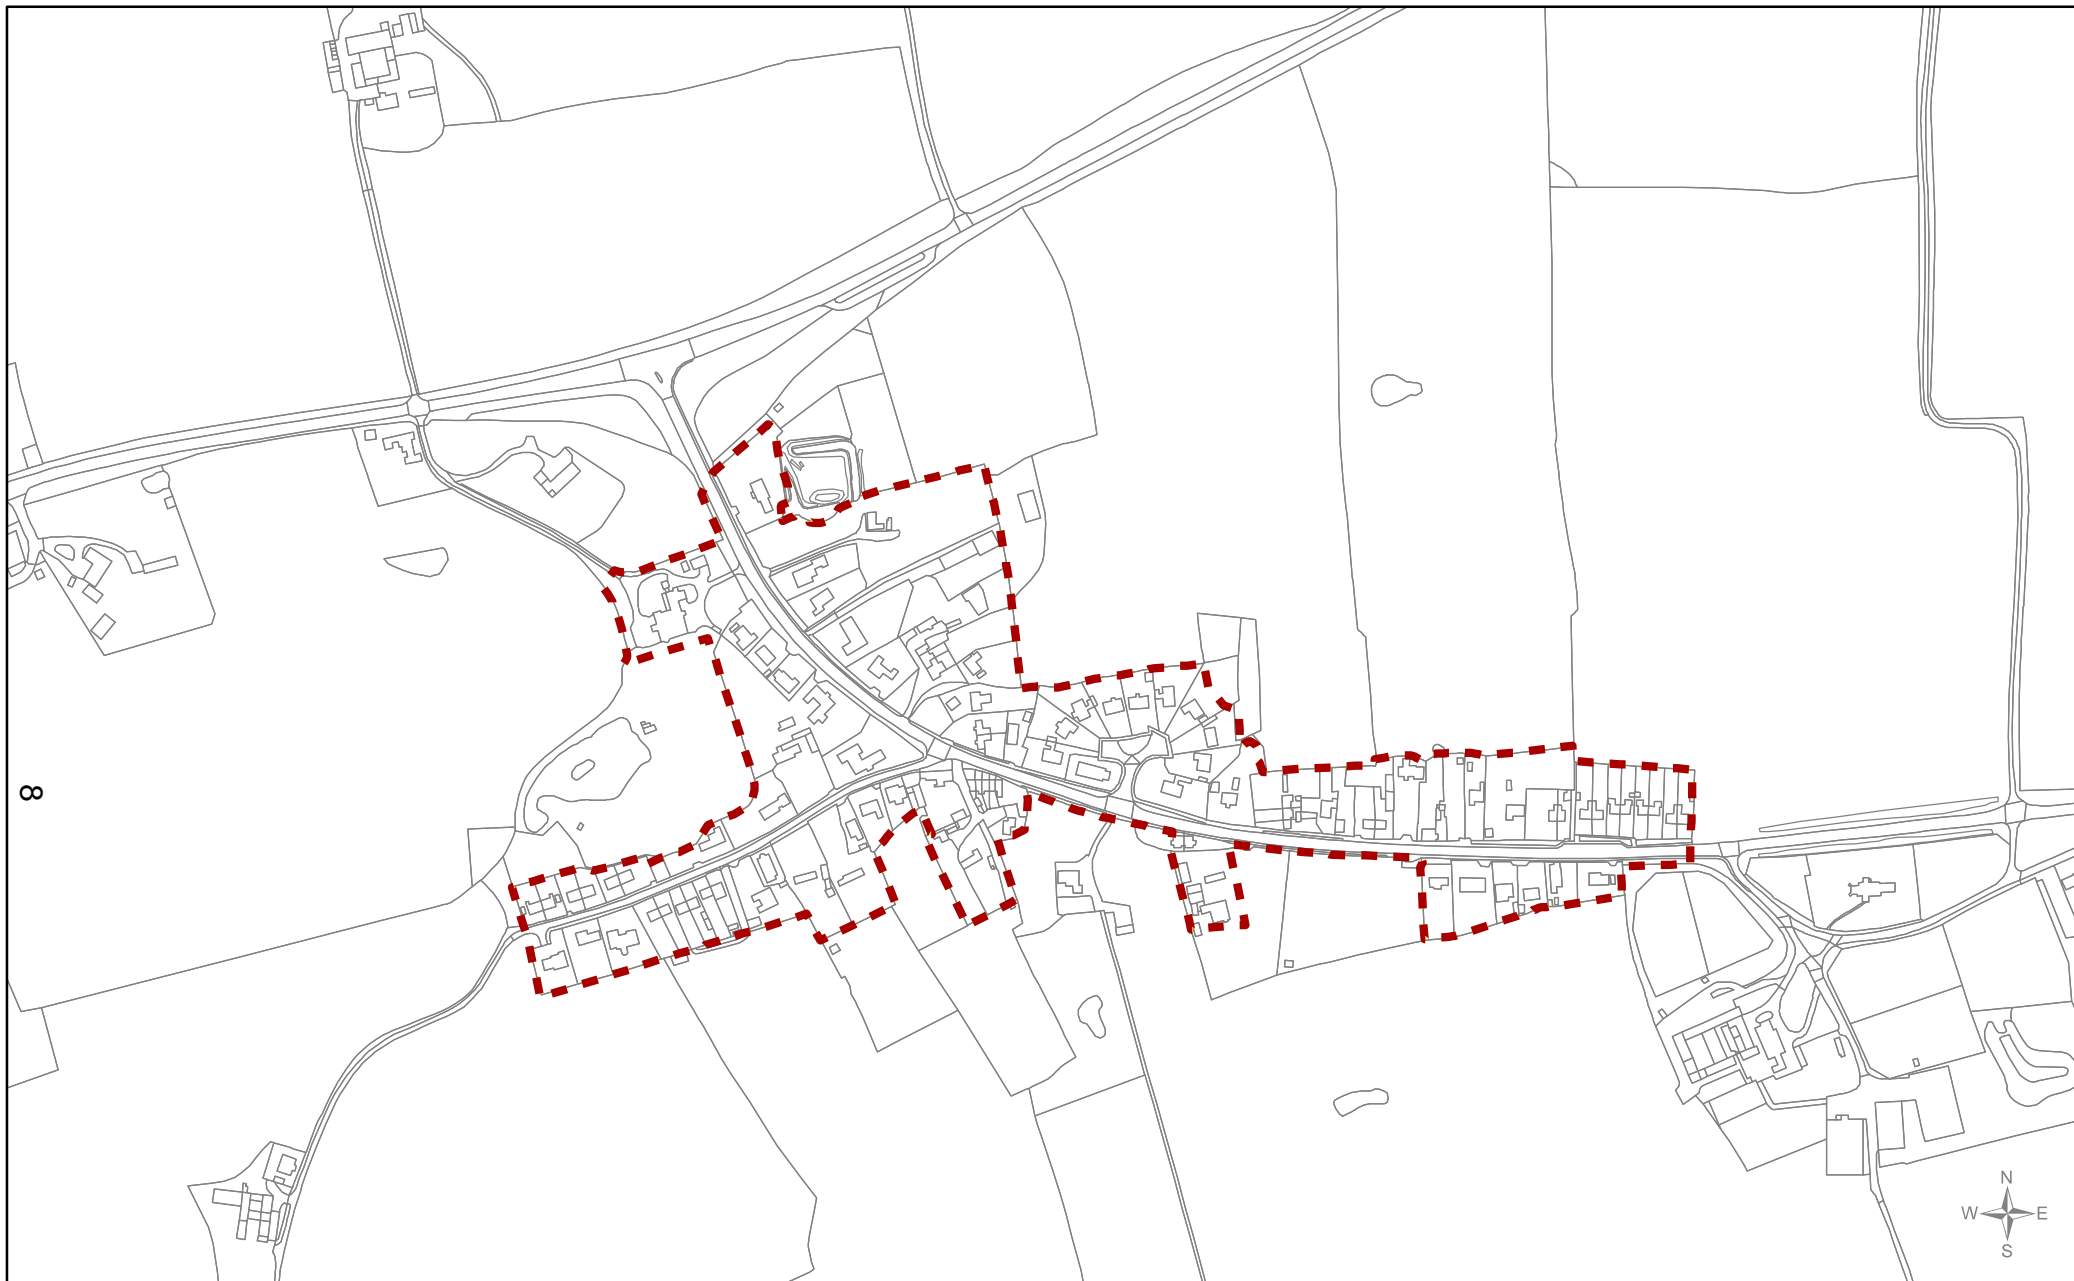

Borough Council of  
**King's Lynn & West Norfolk**  
 Tel. 01553 616200  
 Email: [ldf@west-norfolk.gov.uk](mailto:ldf@west-norfolk.gov.uk)





**Crimplesham**  
**Evolved DRAFT Development Boundary Suggestion**  
  
**Local Plan review (2016 - 2036)**  
**'Smaller Villages and Hamlets'**

Scale  
**1:5,000**  
  
 Drawn by  
**FB/PP**

Date  
**08/09/2017**  
  
 Reference Number  
**021b**

**Legend**

-  Draft boundary suggestions reviewed
-  First draft boundary suggestion




© Crown copyright and  
 database rights 2017  
 Ordnance Survey 100024314





6






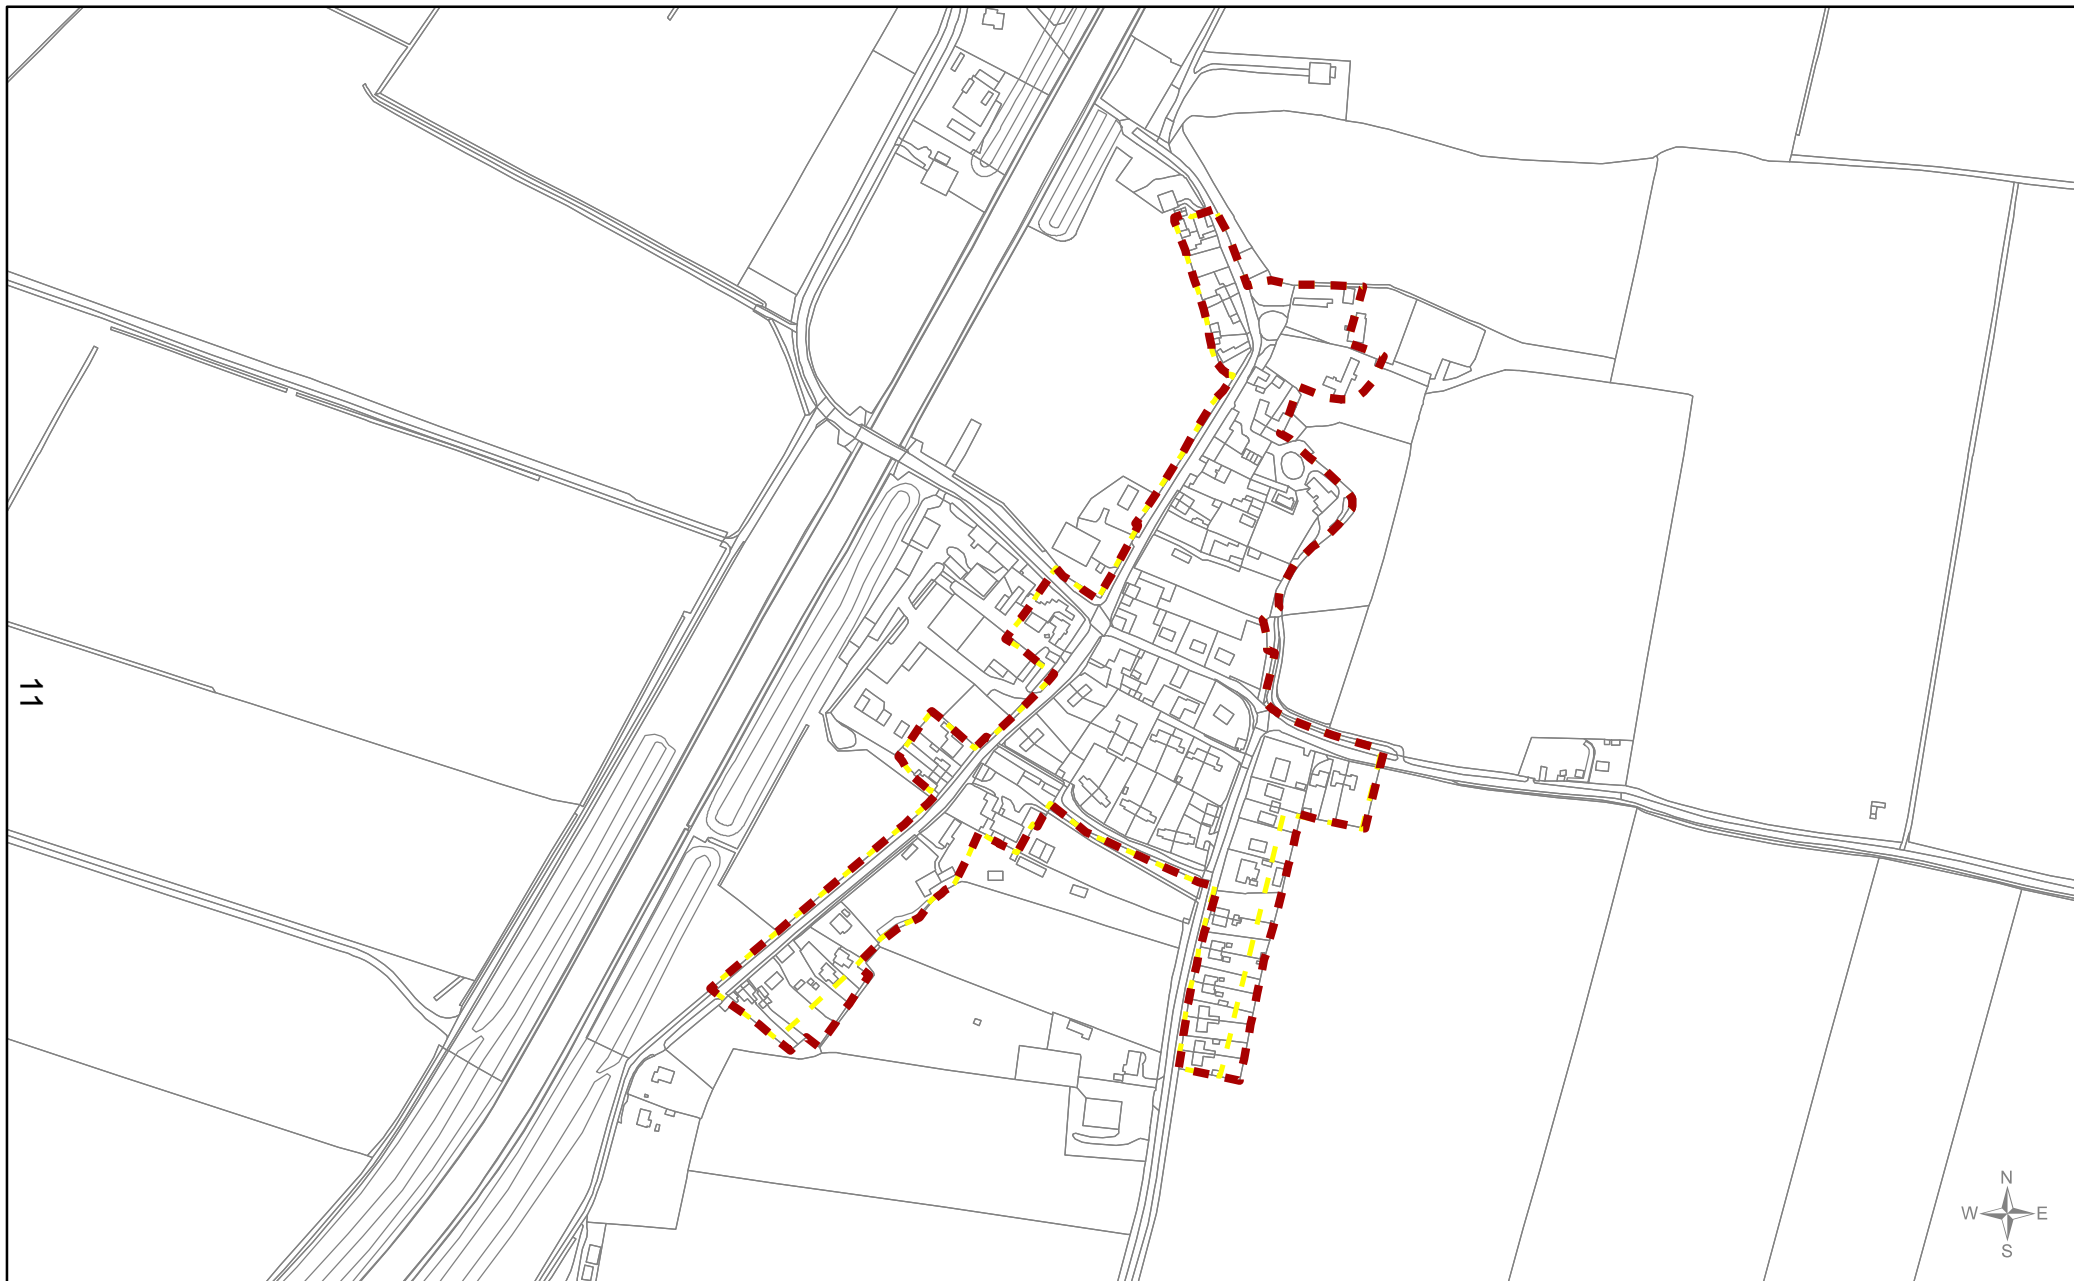
Borough Council of <b>King's Lynn &amp; West Norfolk</b> Tel. 01553 616200 Email: <a href="mailto:ldf@west-norfolk.gov.uk">ldf@west-norfolk.gov.uk</a> 	<b>Hay Green</b> <b>Evolved DRAFT Development Boundary Suggestion</b>	Scale <b>1:5,000</b>	Date <b>08/09/2017</b>	<b>Legend</b>  Draft boundary suggestions reviewed  First draft boundary suggestion	© Crown copyright and database rights 2017 Ordnance Survey 100024314
	<b>Local Plan review (2016 - 2036)</b> <b>'Smaller Villages and Hamlets'</b>	Drawn by <b>FB/PP</b>	Reference Number <b>022b</b>		



10






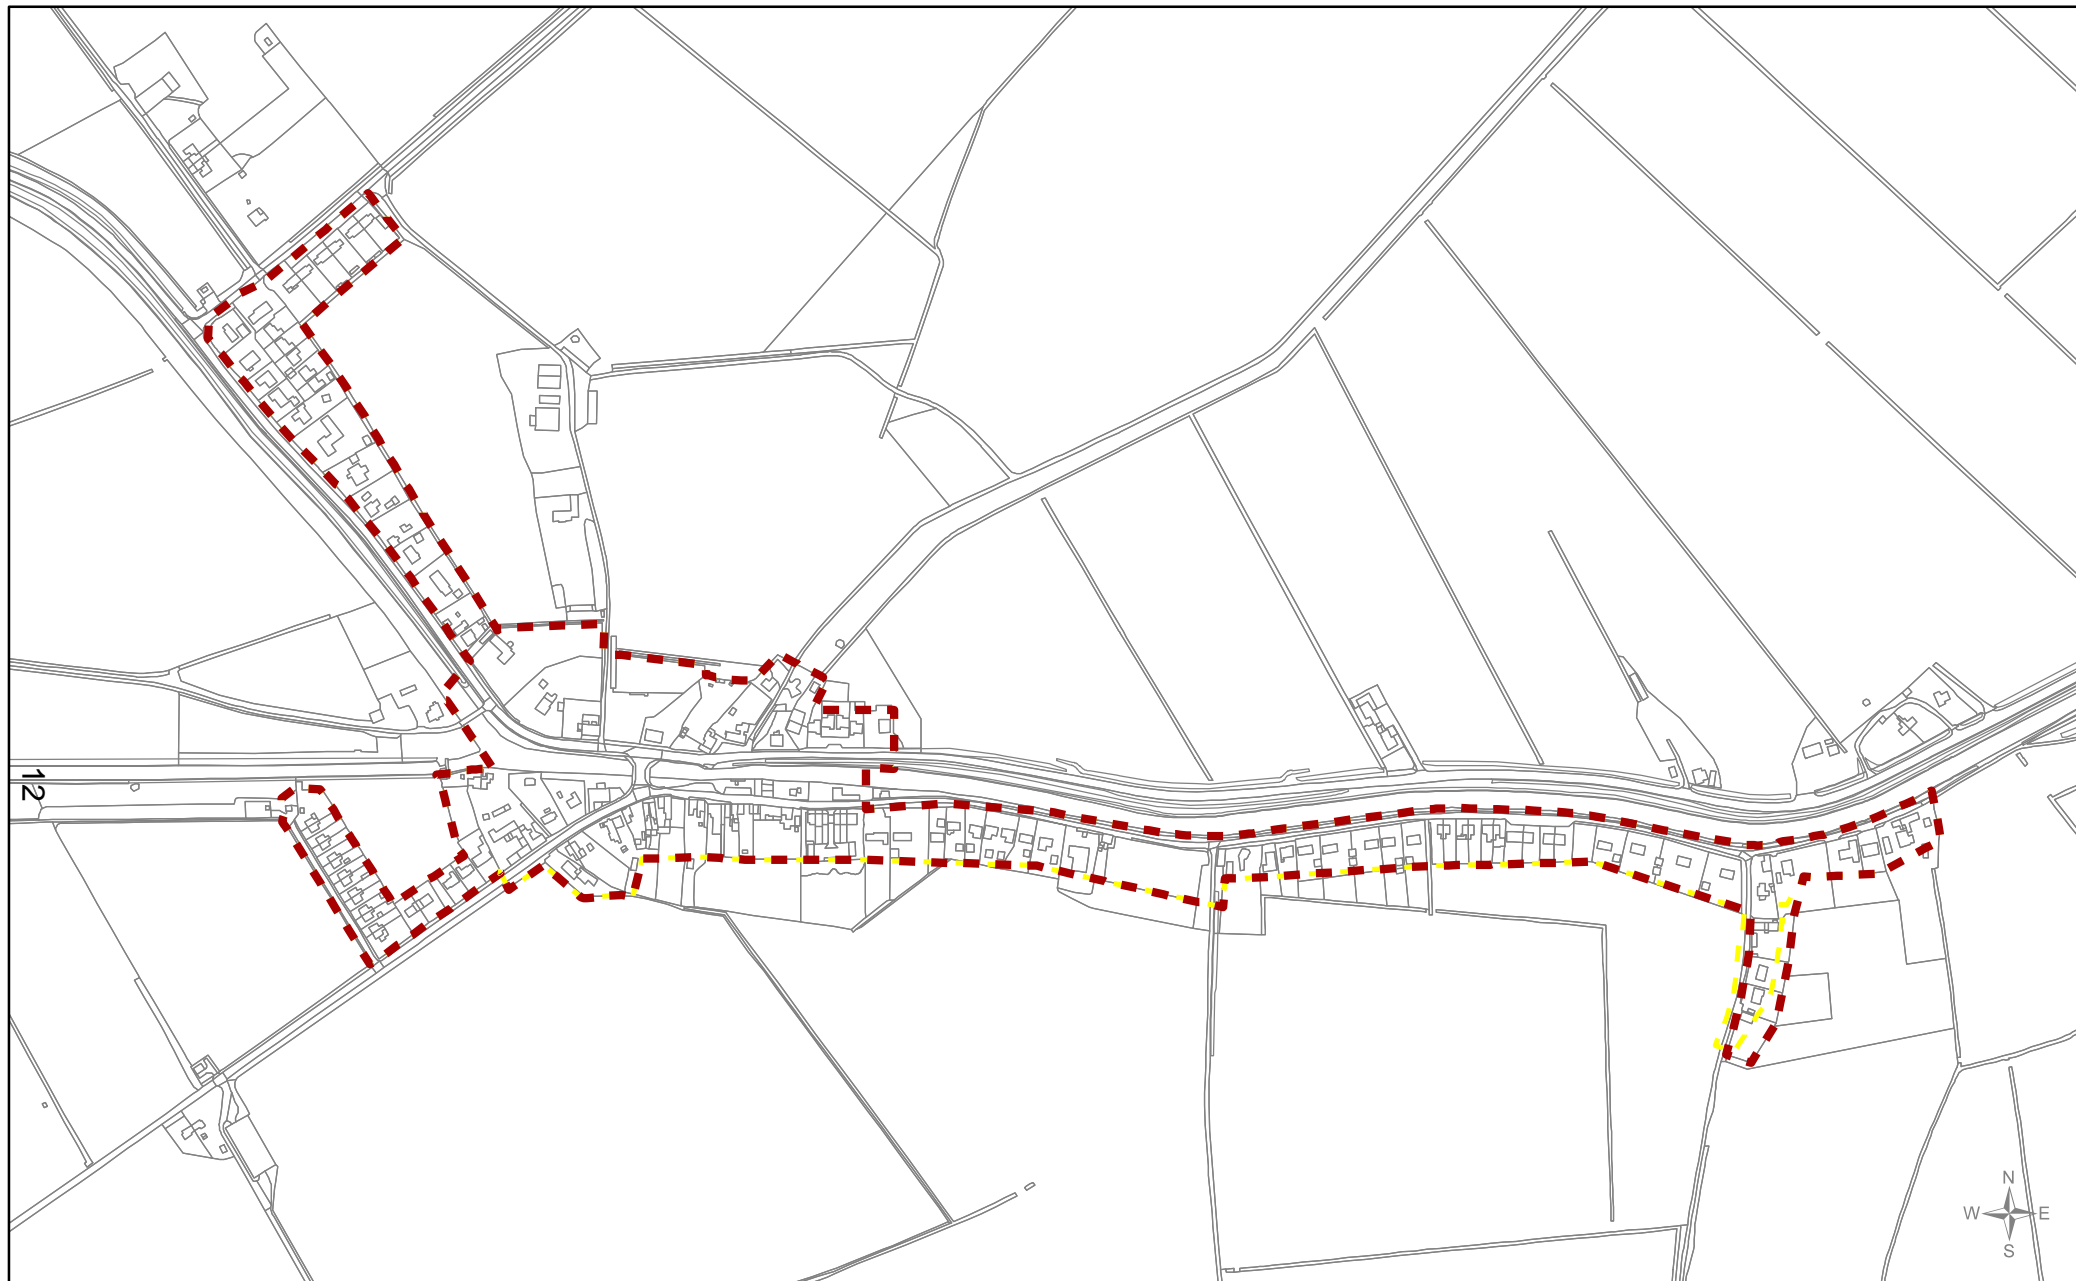
Borough Council of <b>King's Lynn &amp; West Norfolk</b> Tel. 01553 616200 Email: <a href="mailto:ldf@west-norfolk.gov.uk">ldf@west-norfolk.gov.uk</a> 	<b>Lakesend</b> <b>Evolved DRAFT Development Boundary Suggestion</b>	Scale <b>1:5,000</b>	Date <b>08/09/2017</b>	<b>Legend</b>  Draft boundary suggestions reviewed  First draft boundary suggestion	© Crown copyright and database rights 2017 Ordnance Survey 100024314
	<b>Local Plan review (2016 - 2036)</b> <b>'Smaller Villages and Hamlets'</b>	Drawn by <b>FB/PP</b>	Reference Number <b>023b</b>		






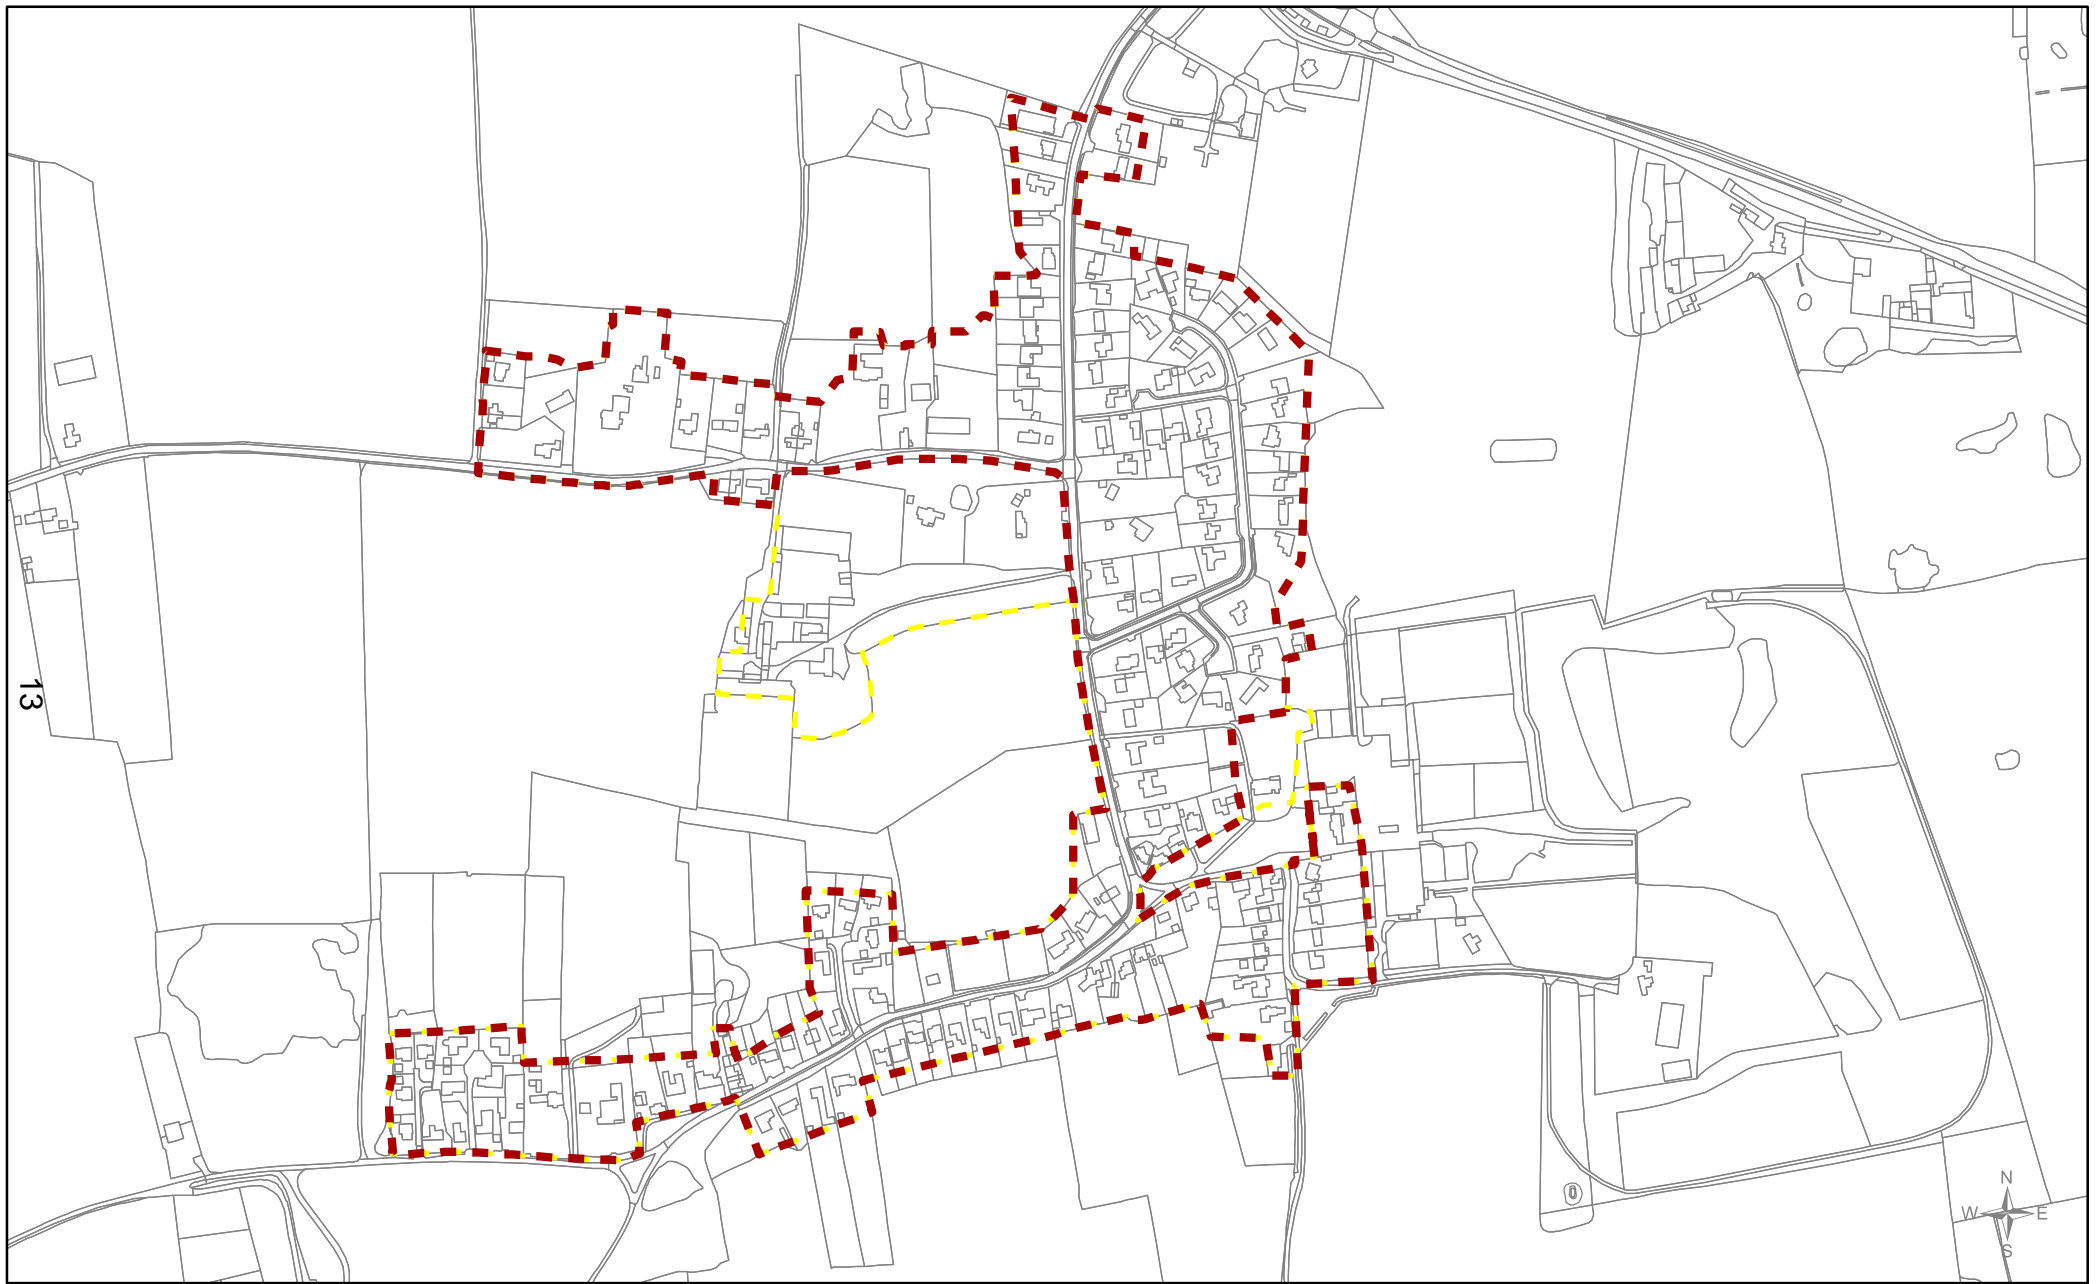
11




Borough Council of <b>King's Lynn &amp; West Norfolk</b> Tel. 01553 616200 Email: <a href="mailto:ldf@west-norfolk.gov.uk">ldf@west-norfolk.gov.uk</a> 	<b>Methwold Hythe</b> <b>Evolved DRAFT Development Boundary Suggestion</b>	Scale <b>1:5,000</b>	Date <b>08/09/2017</b>	<b>Legend</b>  Draft boundary suggestions reviewed  First draft boundary suggestion	© Crown copyright and database rights 2017 Ordnance Survey 100024314
	<b>Local Plan review (2016 - 2036)</b> <b>'Smaller Villages and Hamlets'</b>	Drawn by <b>FB/PP</b>	Reference Number <b>024b</b>		



<p>Borough Council of <b>King's Lynn &amp; West Norfolk</b> Tel. 01553 616200 Email: <a href="mailto:ldf@west-norfolk.gov.uk">ldf@west-norfolk.gov.uk</a></p> 	<p align="center"><b>Nordelph</b> <b>Evolved DRAFT Development Boundary Suggestion</b></p> <p align="center"><b>Local Plan review (2016 - 2036)</b> <b>'Smaller Villages and Hamlets'</b></p>	<p>Scale <b>1:6,000</b></p> <p>Drawn by <b>FB/PP</b></p>	<p>Date <b>08/09/2017</b></p> <p>Reference Number <b>025b</b></p>	<p><b>Legend</b></p> <p> Draft boundary suggestions reviewed</p> <p> First draft boundary suggestion</p>	<p>© Crown copyright and database rights 2017 Ordnance Survey 100024314</p>
---	---	--	---	--	---





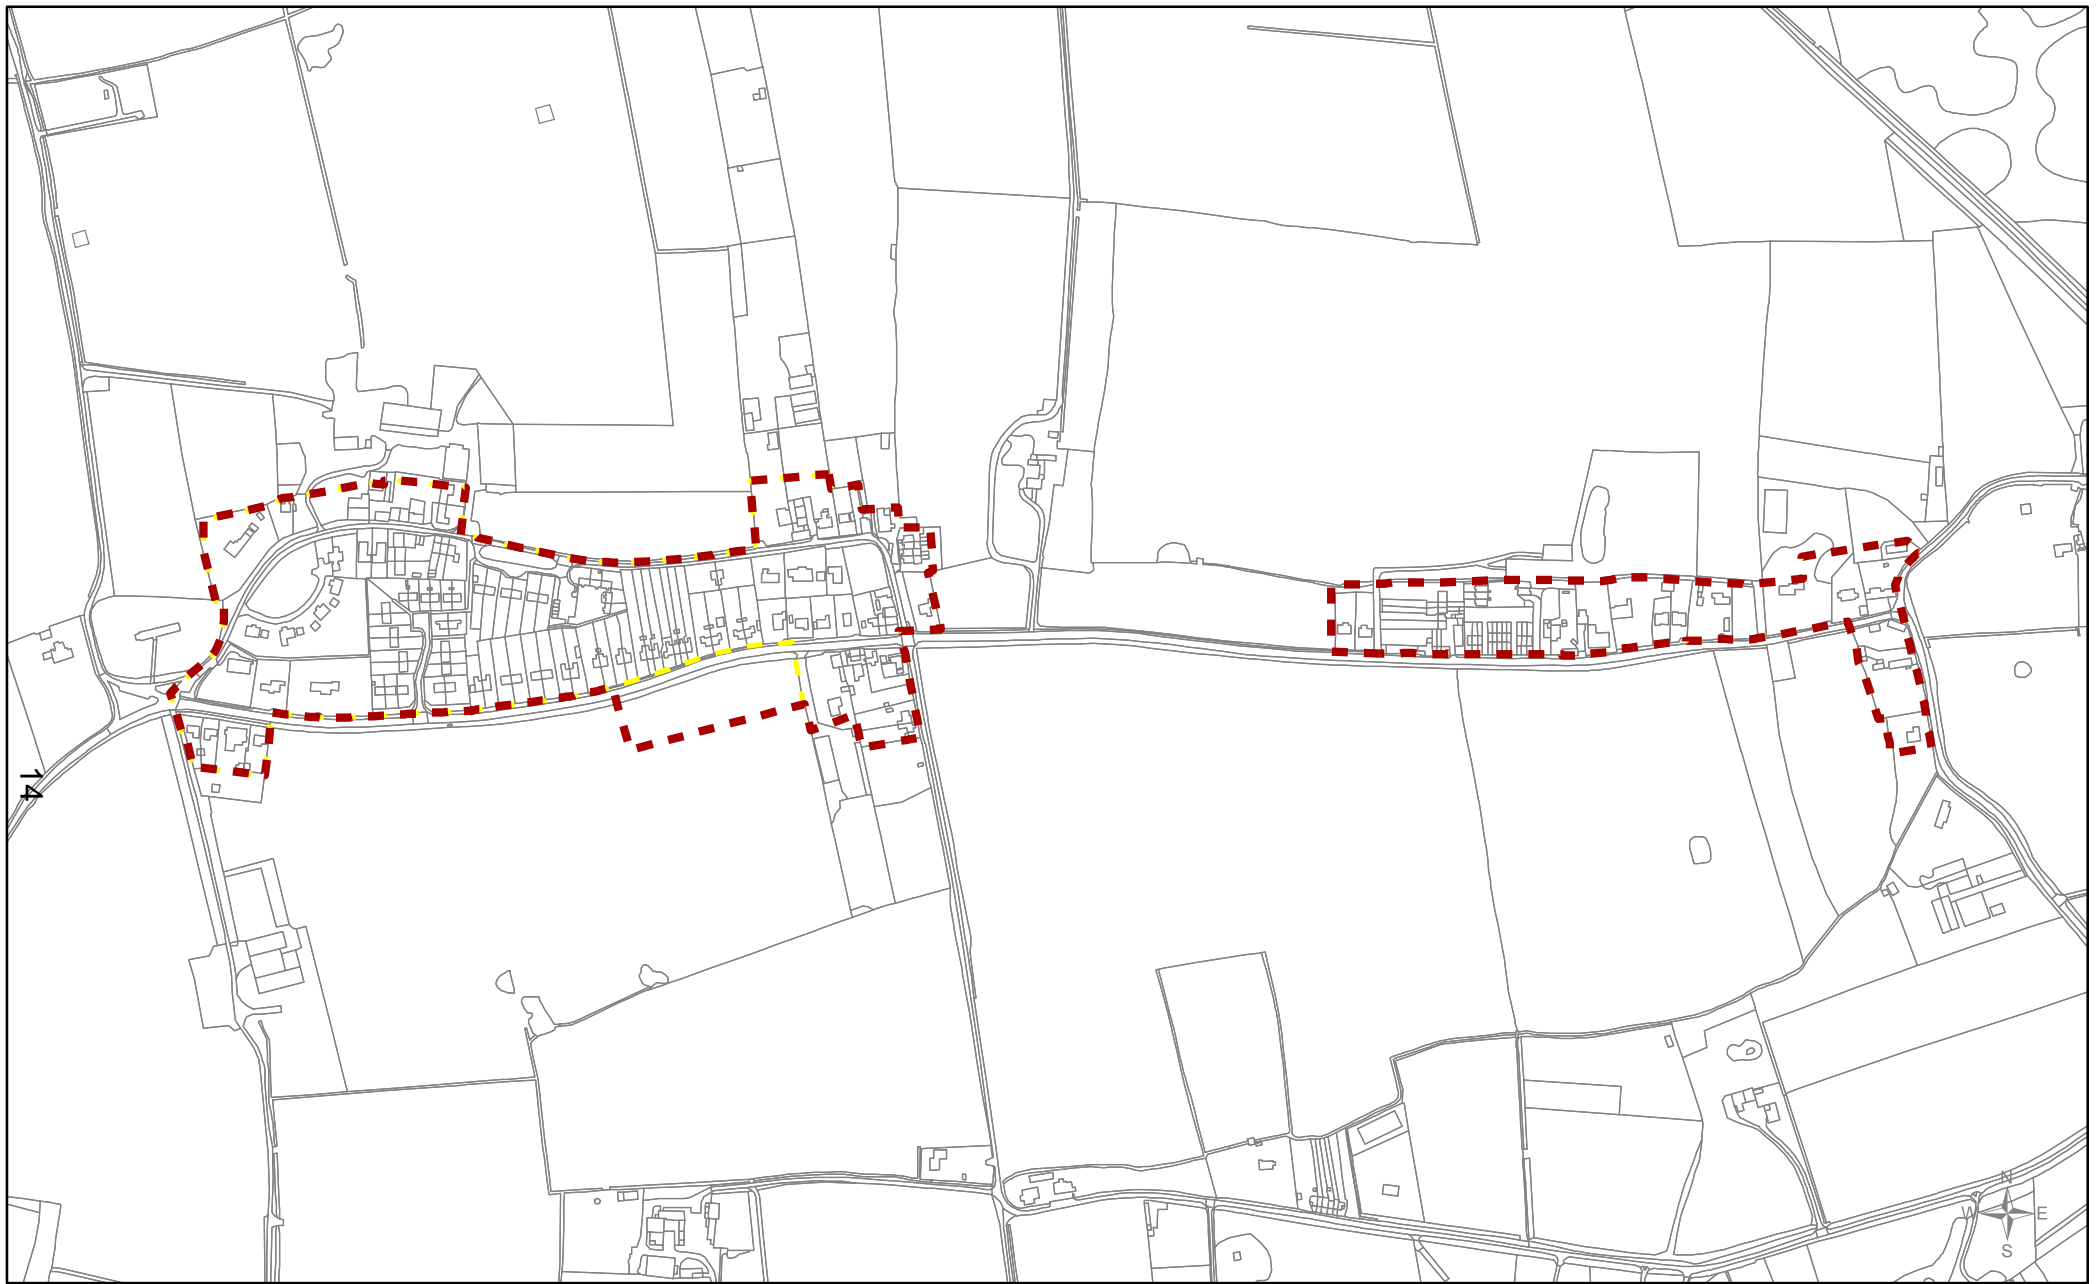



Borough Council of  
**King's Lynn & West Norfolk**  
 Tel. 01553 616200  
 Email: [ldf@west-norfolk.gov.uk](mailto:ldf@west-norfolk.gov.uk)




**Pentney**  
**Evolved DRAFT Development Boundary Suggestion**  
  
**Local Plan review (2016 - 2036)**  
**'Smaller Villages and Hamlets'**

Scale  
**1:6,000**  
  
 Drawn by  
**FB/PP**

Date  
**08/09/2017**  
  
 Reference Number  
**027b**

**Legend**  
 Draft boundary suggestions reviewed  
 First draft boundary suggestion

© Crown copyright and  
 database rights 2017  
 Ordnance Survey 100024314

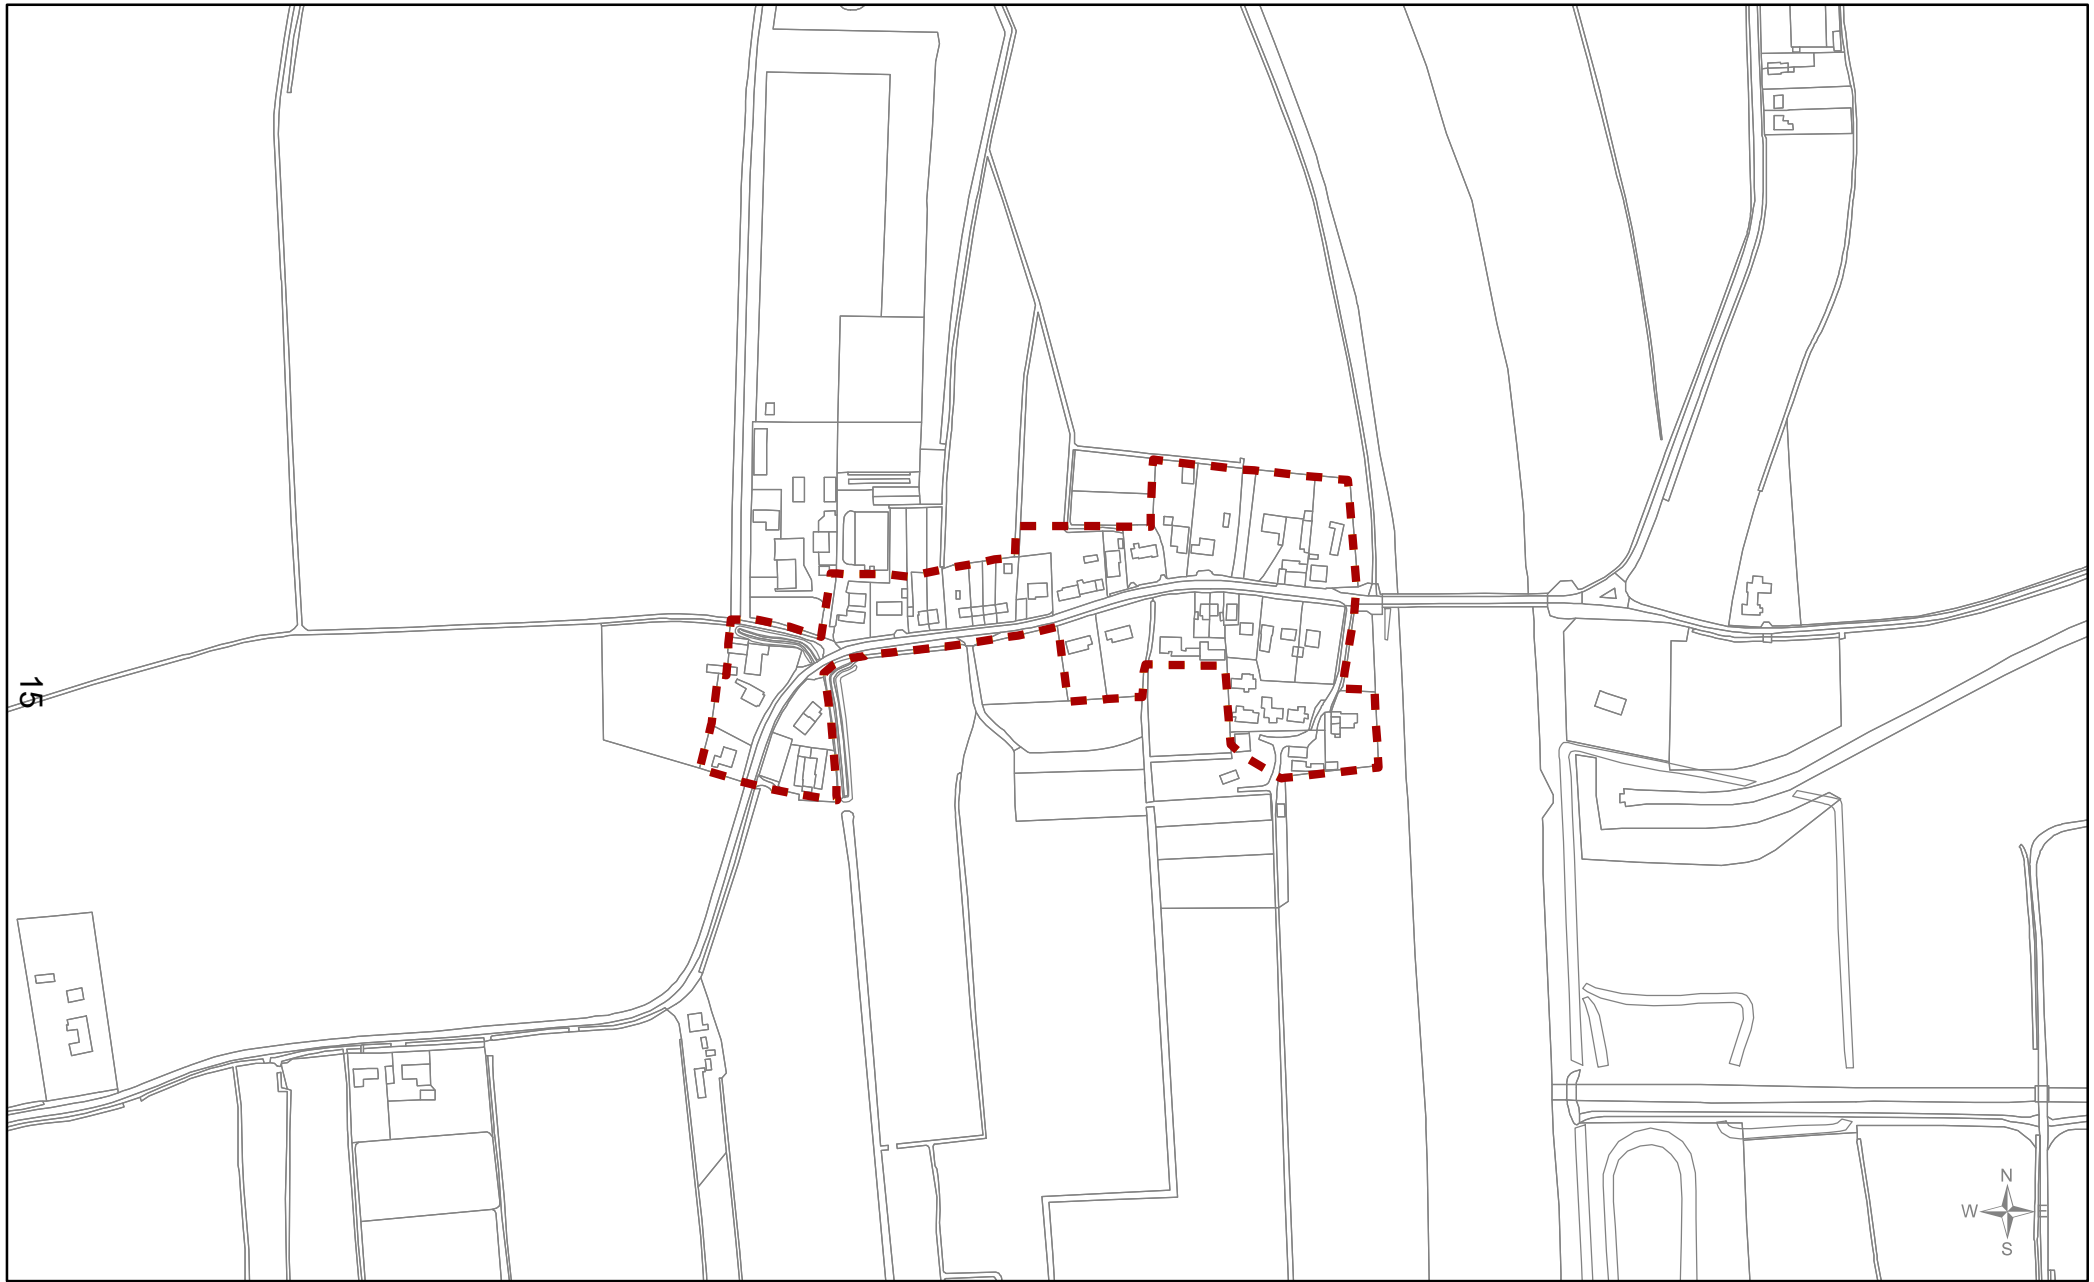

Borough Council of  
**King's Lynn &  
 West Norfolk**  
 Tel. 01553 616200  
 Email: [ldf@west-norfolk.gov.uk](mailto:ldf@west-norfolk.gov.uk)



**Saddlebow**  
 Evolved DRAFT Development Boundary Suggestion

**Local Plan review (2016 - 2036)**  
 'Smaller Villages and Hamlets'


Scale  
**1:5,000**


Drawn by  
**FB/PP**

Date  
**08/09/2017**


Reference Number  
**028b**


**Legend**




 Draft boundary suggestions reviewed

 First draft boundary suggestion

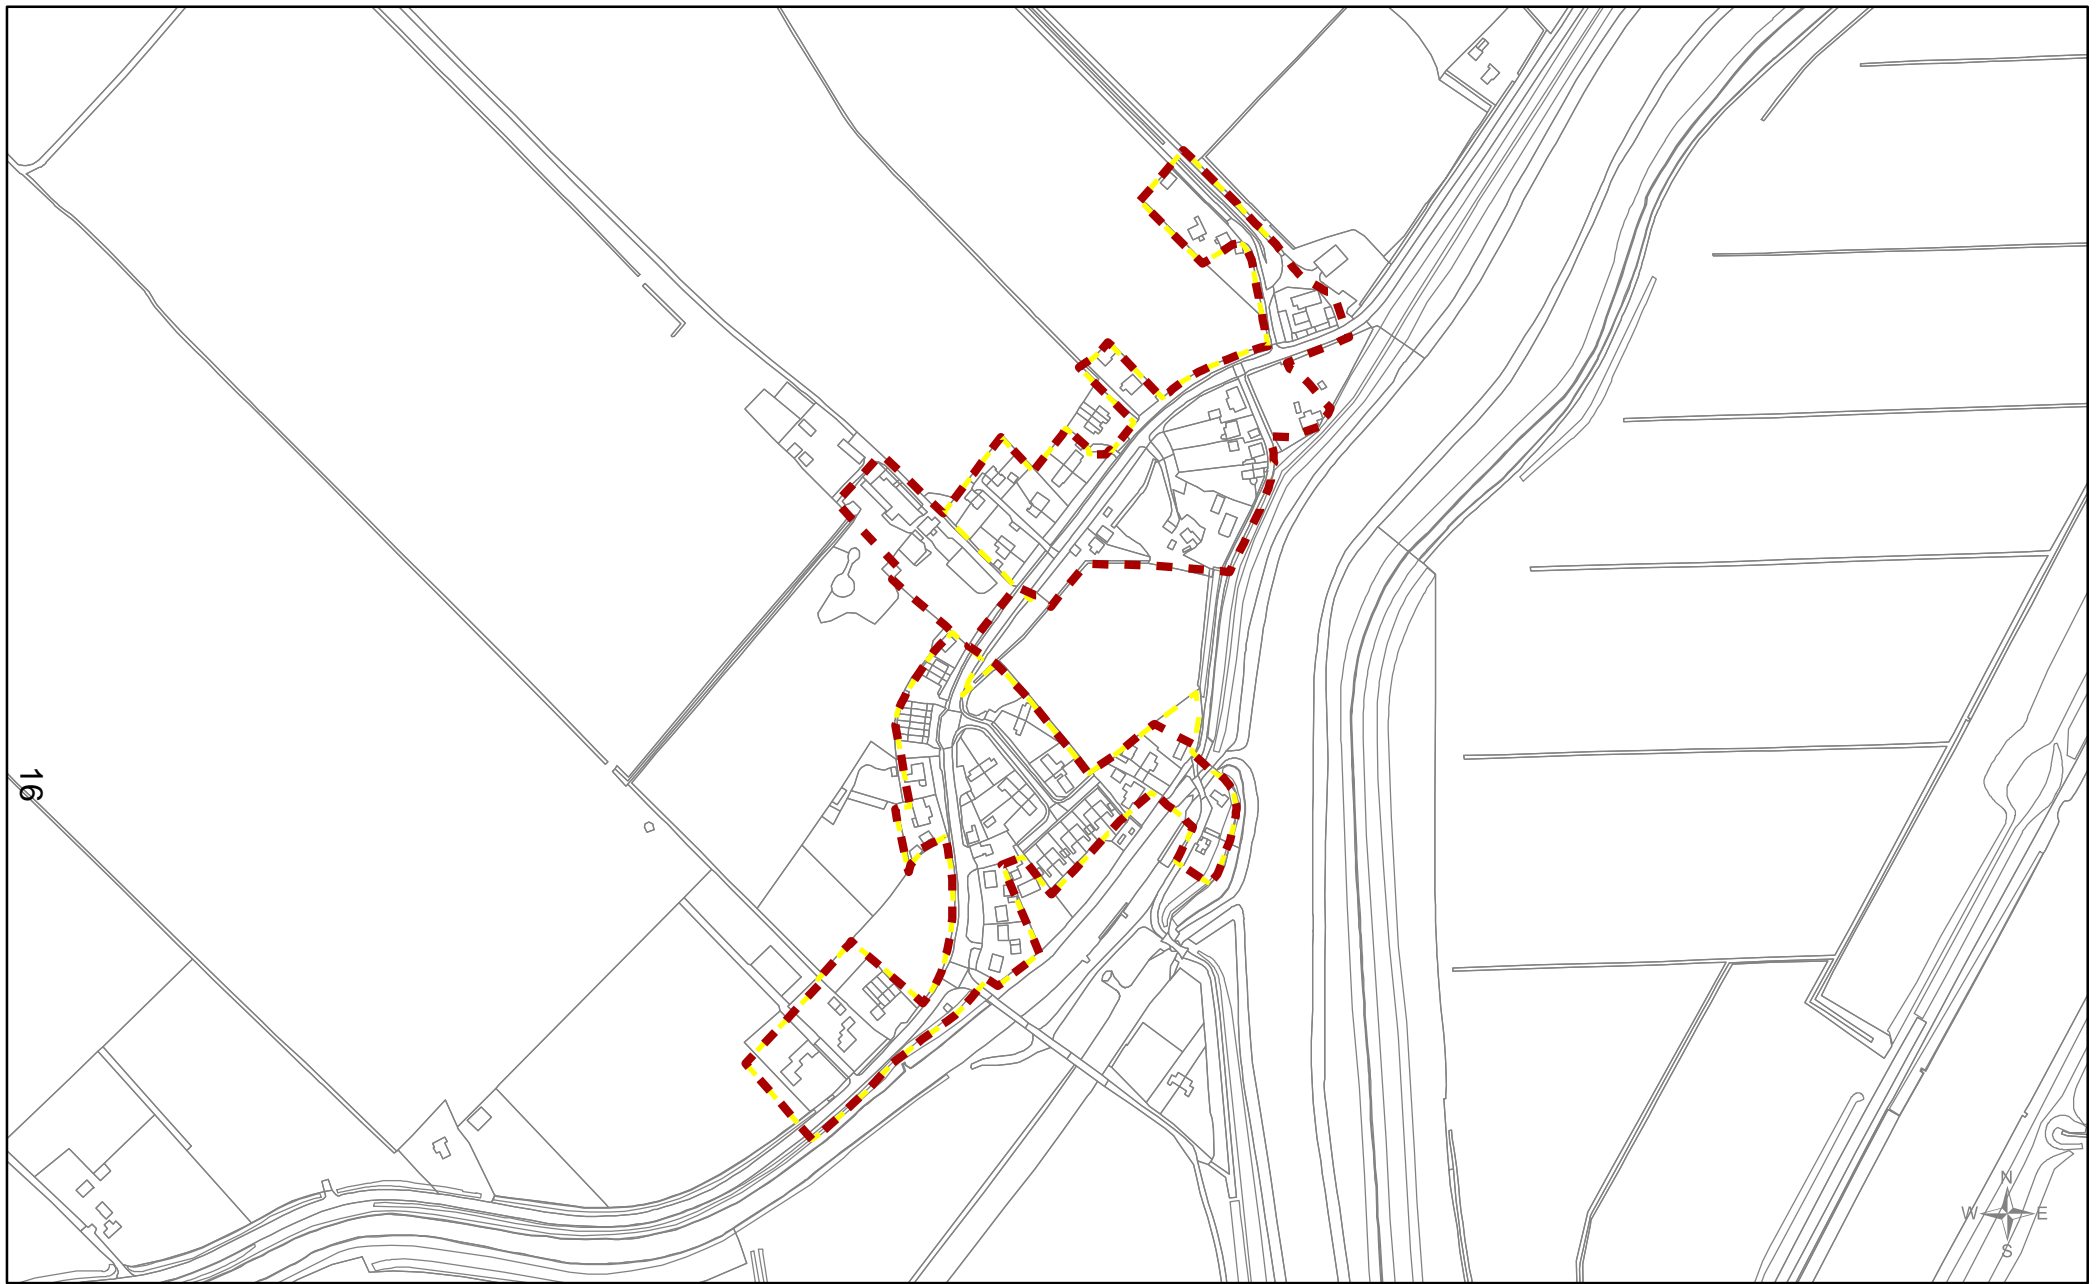© Crown copyright and  
 database rights 2017  
 Ordnance Survey 100024314

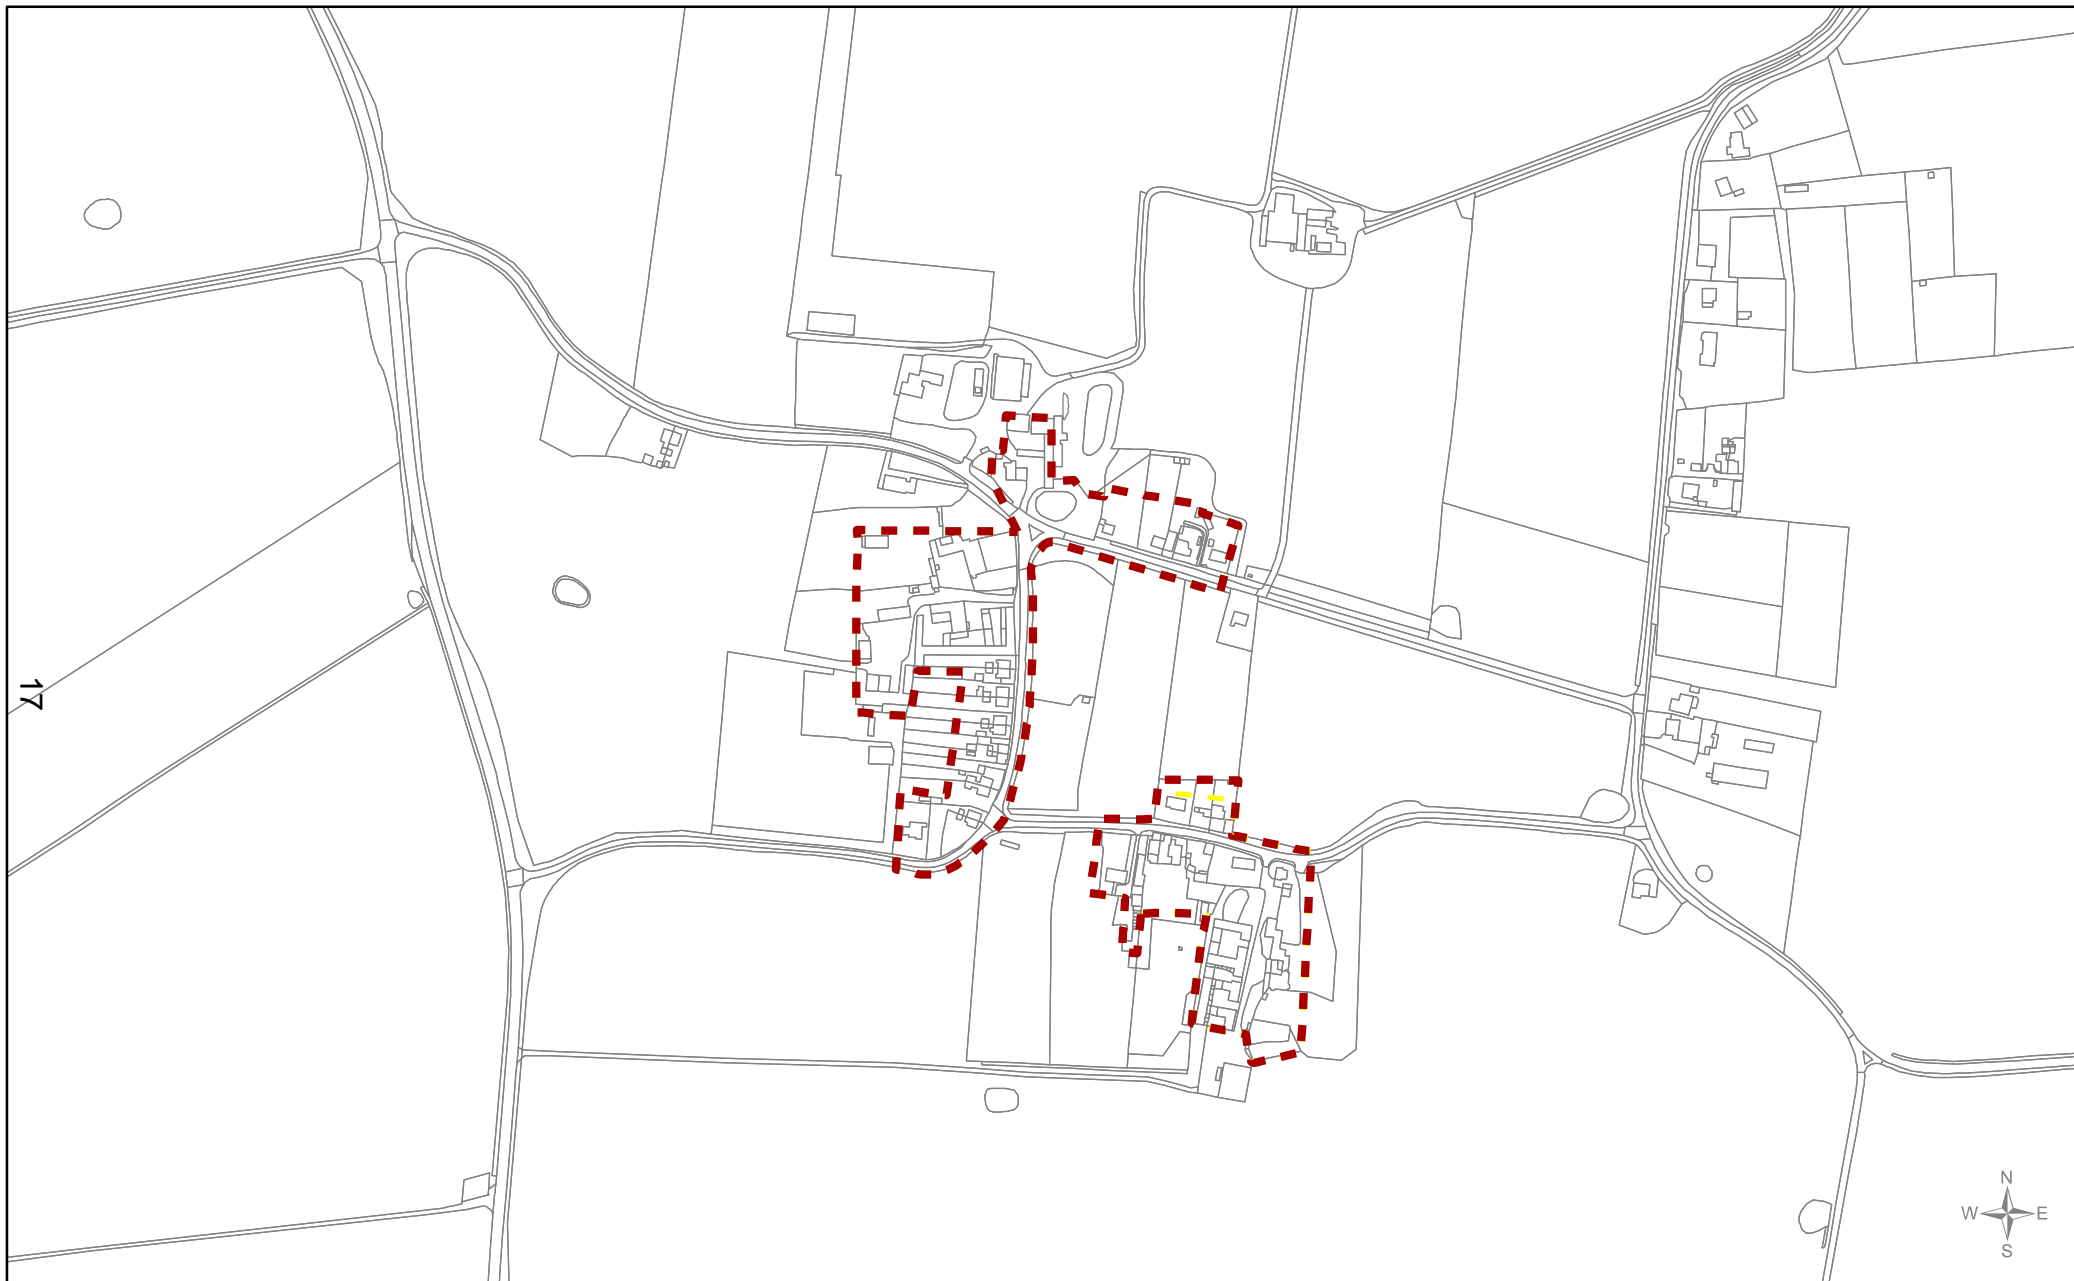



Borough Council of <b>King's Lynn &amp; West Norfolk</b> Tel. 01553 616200 Email: <a href="mailto:ldf@west-norfolk.gov.uk">ldf@west-norfolk.gov.uk</a> 	<b>Shouldham Thorpe</b> <b>Evolved DRAFT Development Boundary Suggestion</b>		Scale <b>1:5,000</b>	Date <b>08/09/2017</b>	<b>Legend</b>  Draft boundary suggestions reviewed  First draft boundary suggestion	© Crown copyright and database rights 2017 Ordnance Survey 100024314
	<b>Local Plan review (2016 - 2036)</b> <b>'Smaller Villages and Hamlets'</b>		Drawn by <b>FB/PP</b>	Reference Number <b>030b</b>		



Borough Council of  
**King's Lynn &  
 West Norfolk**  
 Tel. 01553 616200  
 Email: [ldf@west-norfolk.gov.uk](mailto:ldf@west-norfolk.gov.uk)



**Tilney cum Islington  
 Evolved DRAFT Development Boundary Suggestion**

**Local Plan review (2016 - 2036)  
 'Smaller Villages and Hamlets'**



Scale  
**1:6,000**

Drawn by  
**FB/PP**

Date  
**08/09/2017**


Reference Number  
**031b**


**Legend**

-  Draft boundary suggestions reviewed
-  First draft boundary suggestion

© Crown copyright and  
 database rights 2017  
 Ordnance Survey 100024314



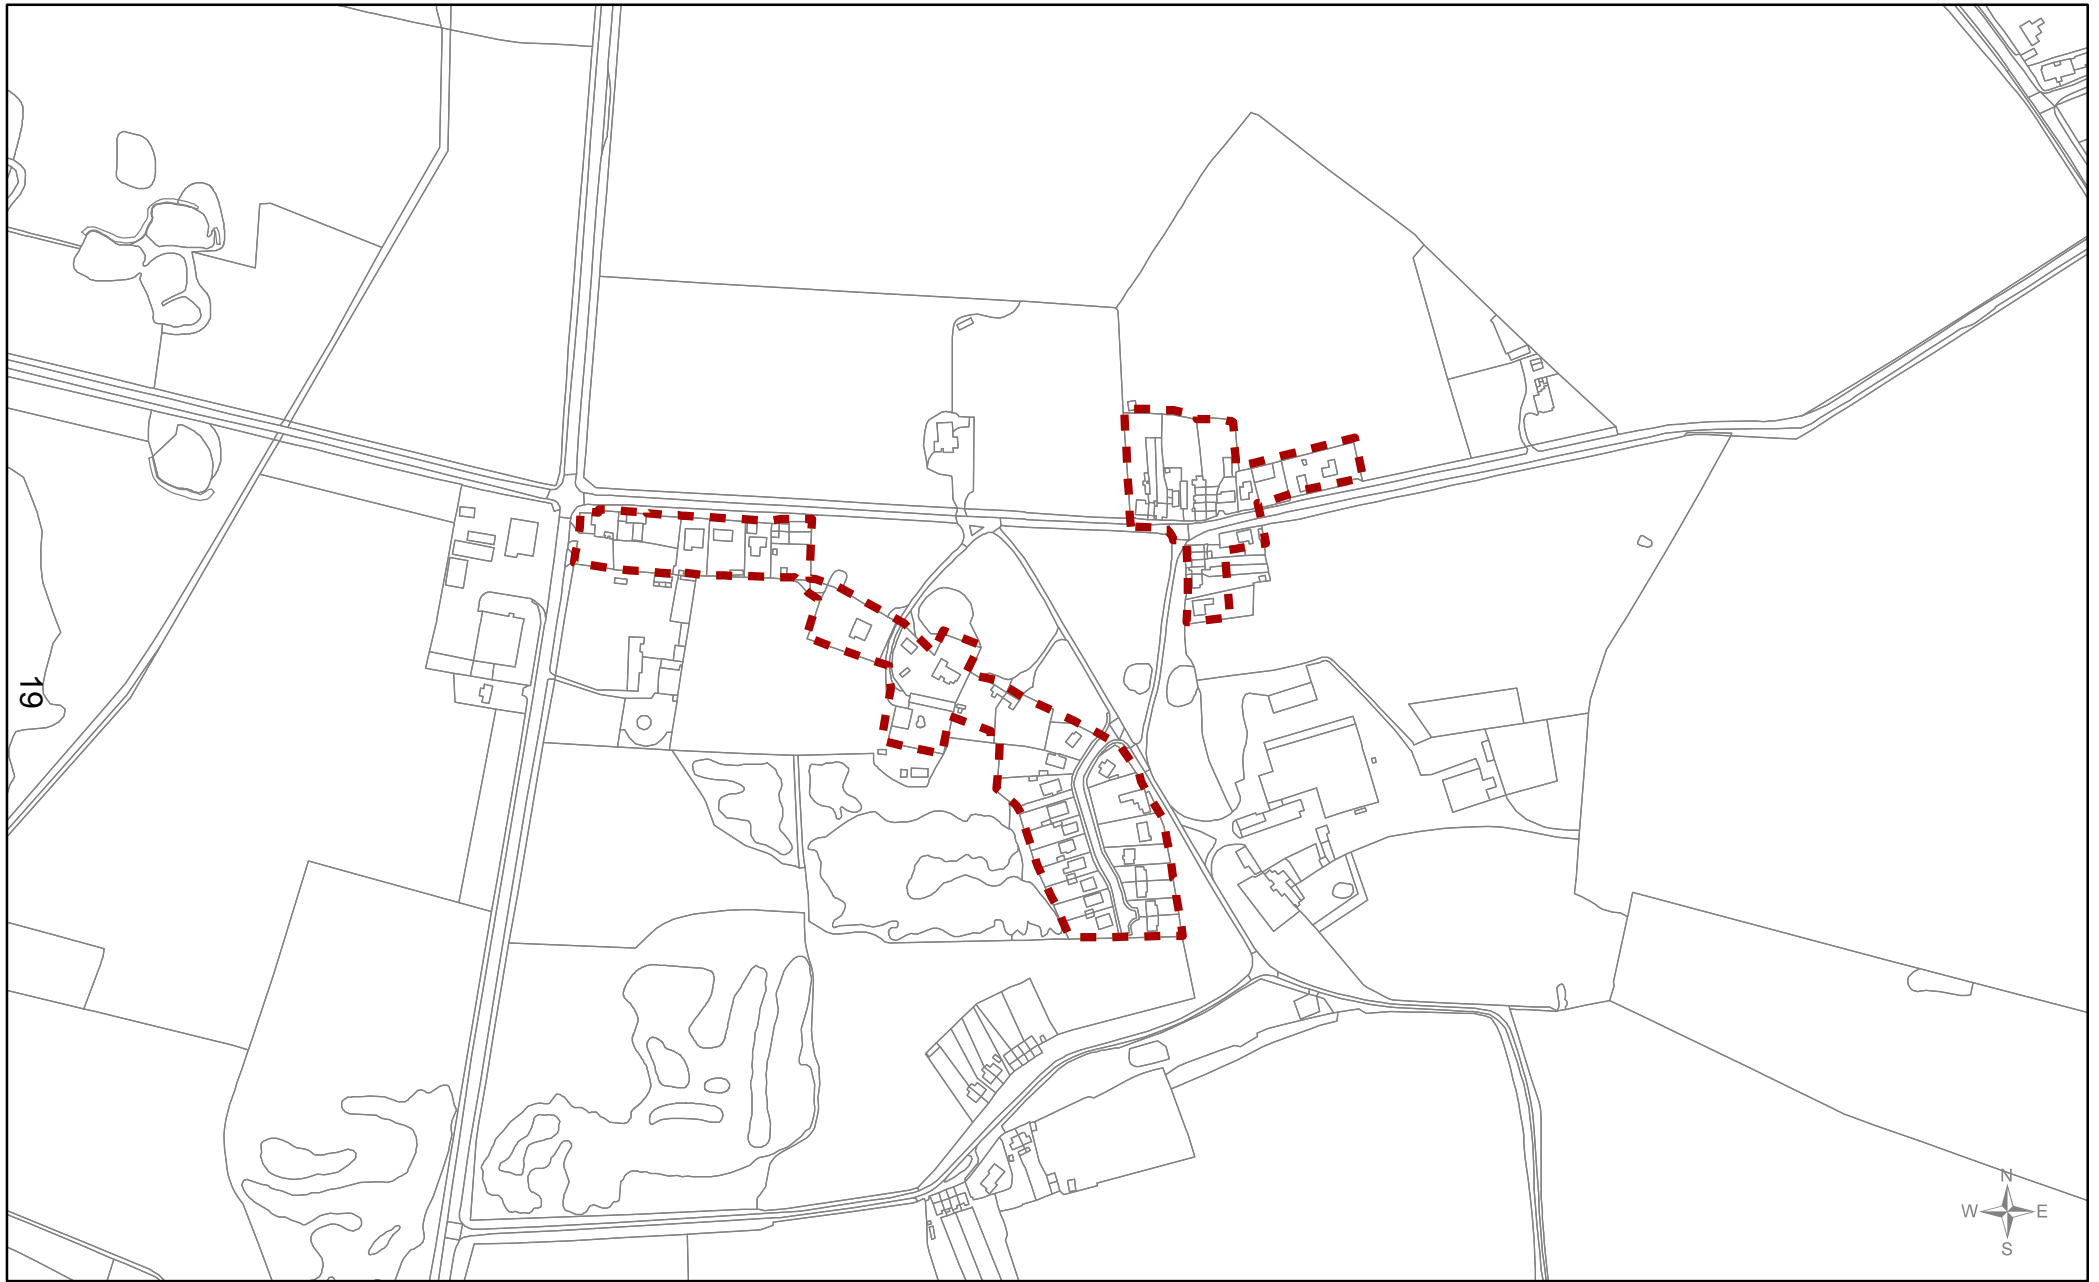

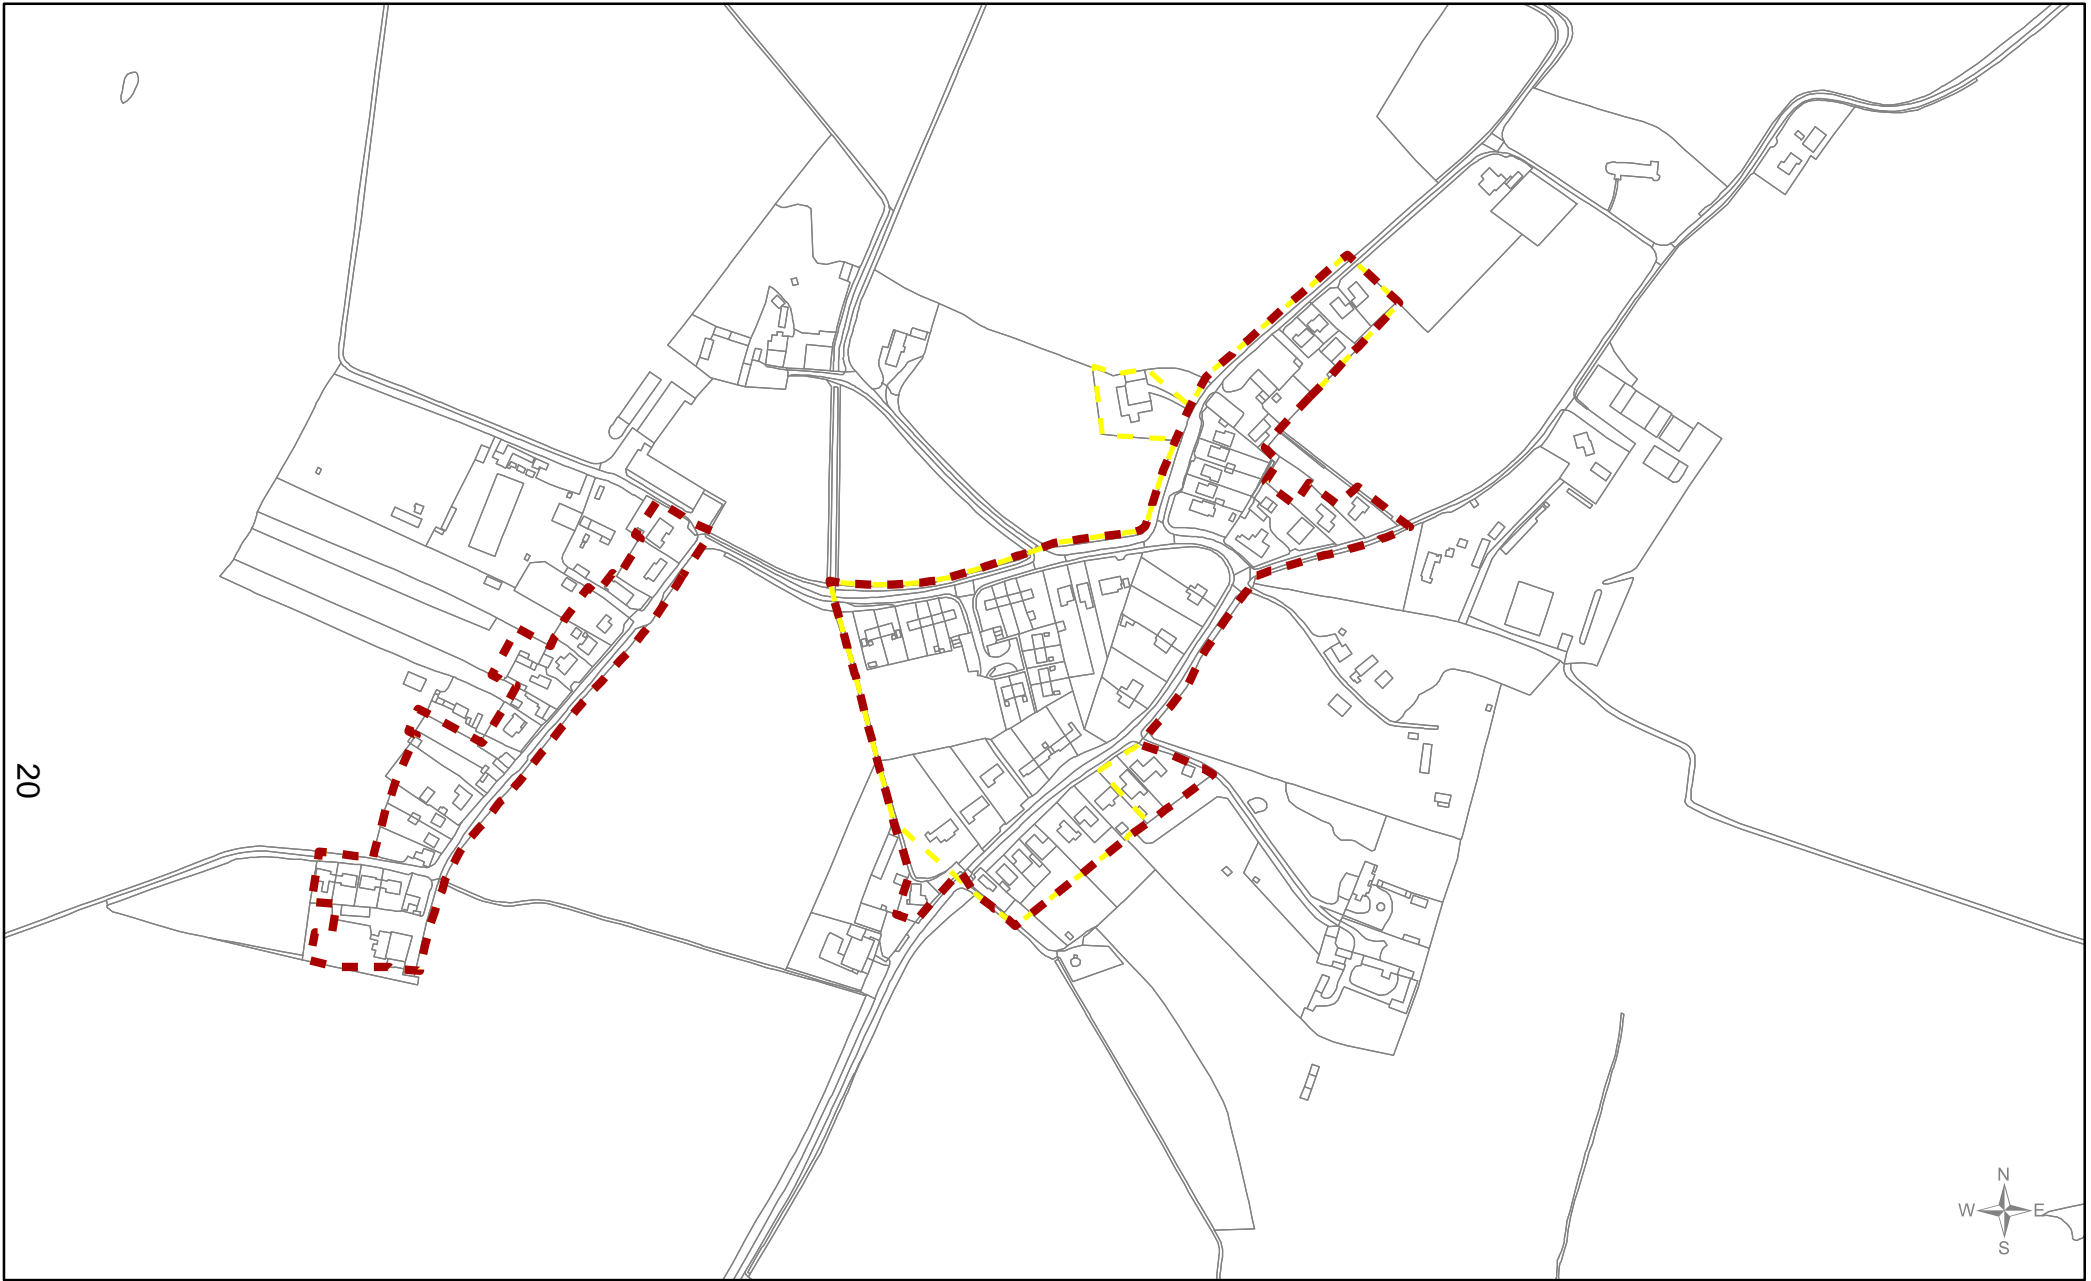




20



Borough Council of <b>King's Lynn &amp; West Norfolk</b> Tel. 01553 616200 Email: <a href="mailto:ldf@west-norfolk.gov.uk">ldf@west-norfolk.gov.uk</a> 	<b>West Dereham (North)</b> <b>Evolved DRAFT Development Boundary Suggestion</b>	Scale <b>1:5,000</b>	Date <b>08/09/2017</b>	<b>Legend</b>  Draft boundary suggestions reviewed  First draft boundary suggestion	© Crown copyright and database rights 2017 Ordnance Survey 100024314
	<b>Local Plan review (2016 - 2036)</b> <b>'Smaller Villages and Hamlets'</b>	Drawn by <b>FB/PP</b>	Reference Number <b>033b_N</b>		





Borough Council of  
**King's Lynn &  
 West Norfolk**  
 Tel. 01553 616200  
 Email: [ldf@west-norfolk.gov.uk](mailto:ldf@west-norfolk.gov.uk)





**West Dereham (overview)**  
**Evolved DRAFT Development Boundary Suggestion**  
  
**Local Plan review (2016 - 2036)**  
**'Smaller Villages and Hamlets'**


Scale  
**1:10,000**  
  
 Drawn by  
**FB/PP**

Date  
**08/09/2017**  
  
 Reference Number  
**033b**

**Legend**

-  Draft boundary suggestions reviewed
-  First draft boundary suggestion

© Crown copyright and  
 database rights 2017  
 Ordnance Survey 100024314

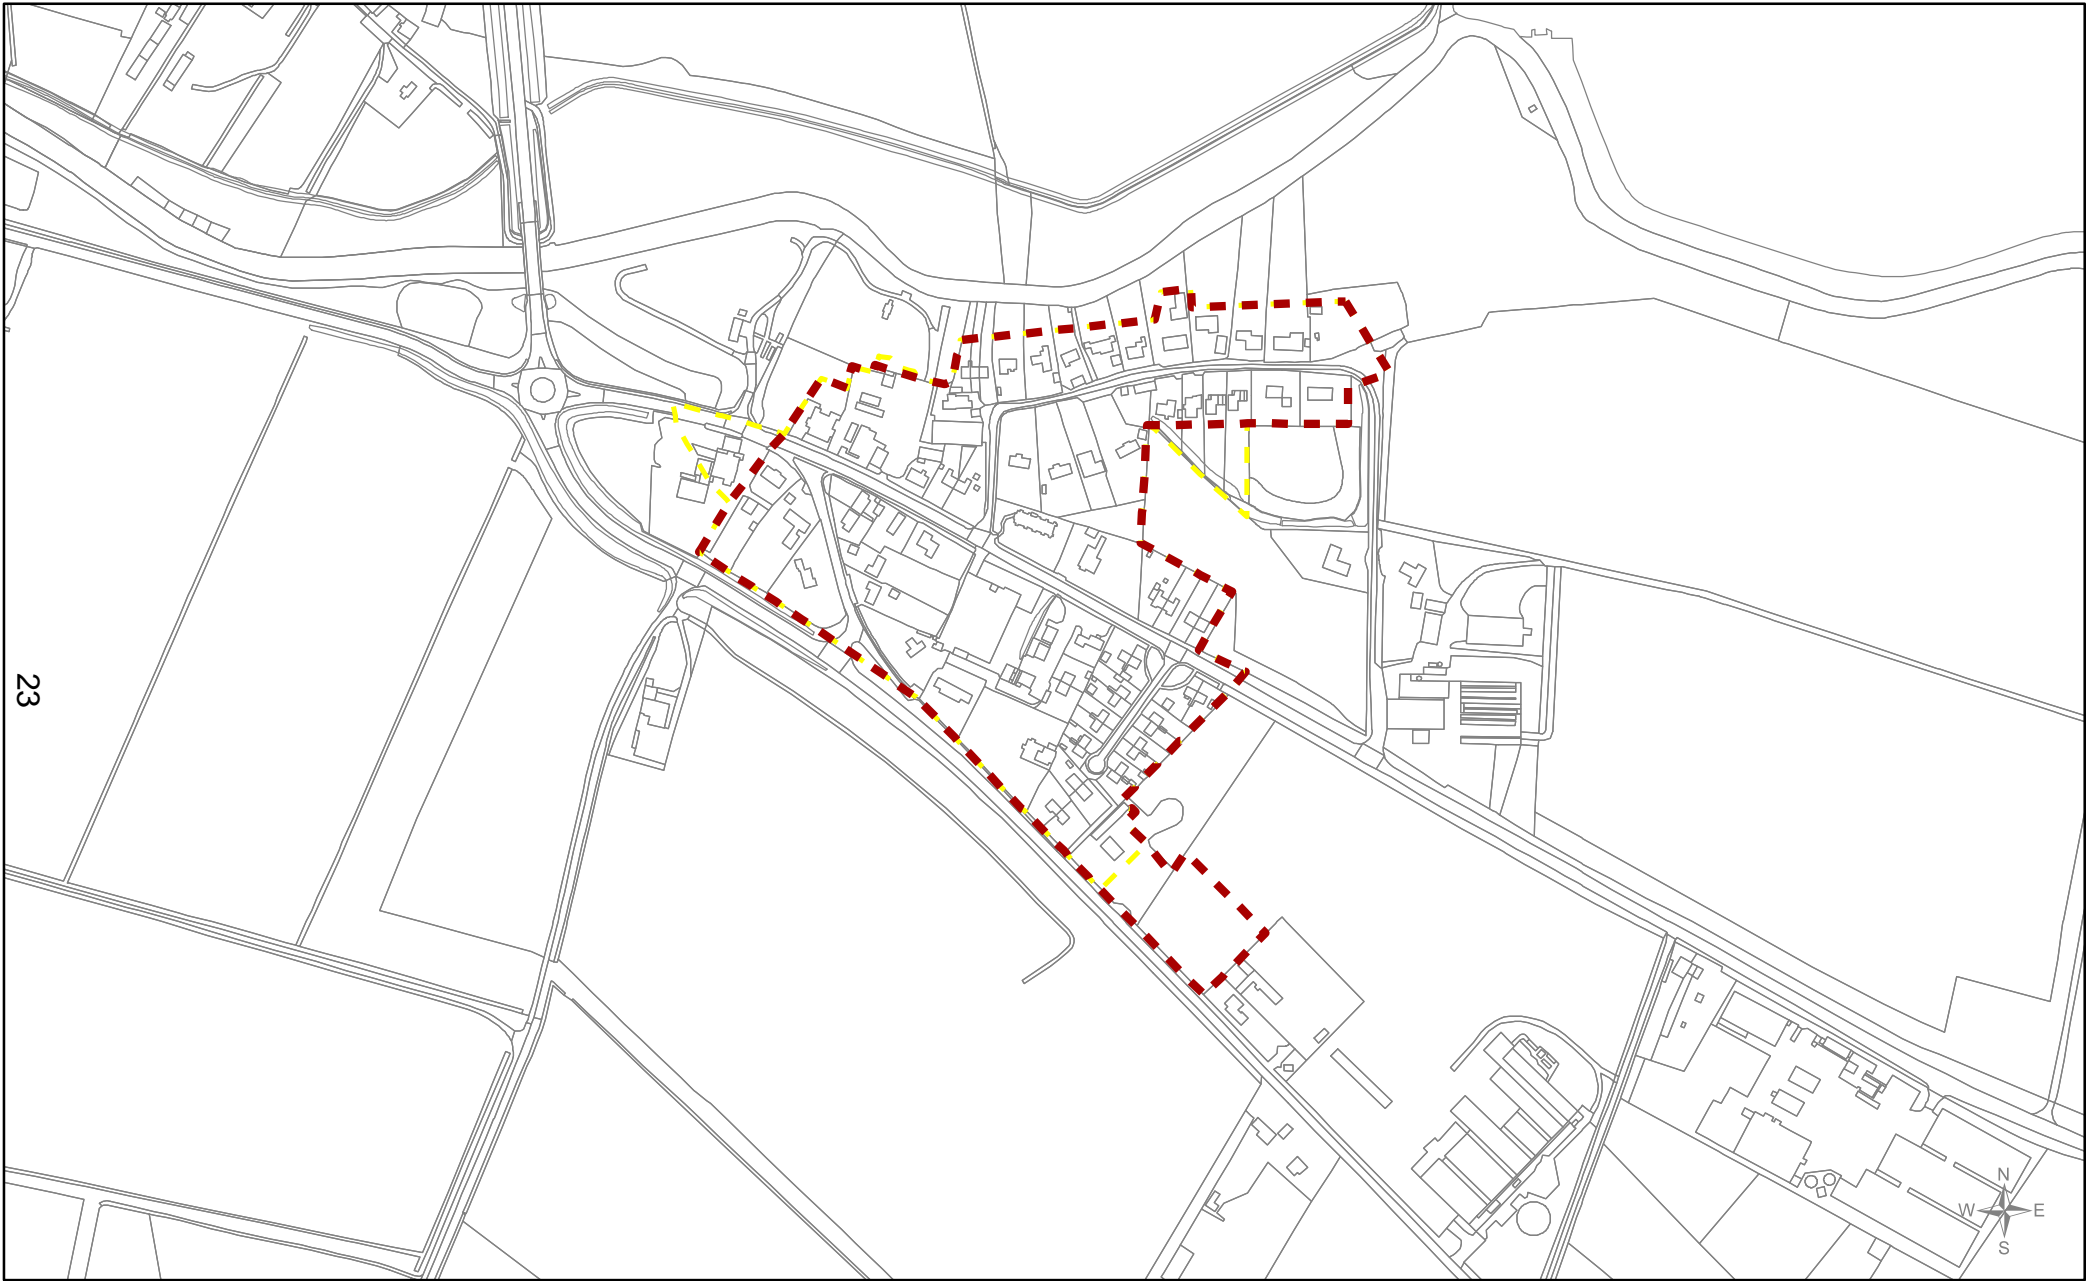

Borough Council of  
**King's Lynn &  
 West Norfolk**  
 Tel. 01553 616200  
 Email: [ldf@west-norfolk.gov.uk](mailto:ldf@west-norfolk.gov.uk)



**Whittington**  
 Evolved DRAFT Development Boundary Suggestion

**Local Plan review (2016 - 2036)**  
 'Smaller Villages and Hamlets'


Scale  
**1:5,000**


Drawn by  
**FB/PP**

Date  
**08/09/2017**

Reference Number  
**034b**


**Legend**

 Draft boundary suggestions reviewed

 First draft boundary suggestion

© Crown copyright and  
 database rights 2017  
 Ordnance Survey 100024314



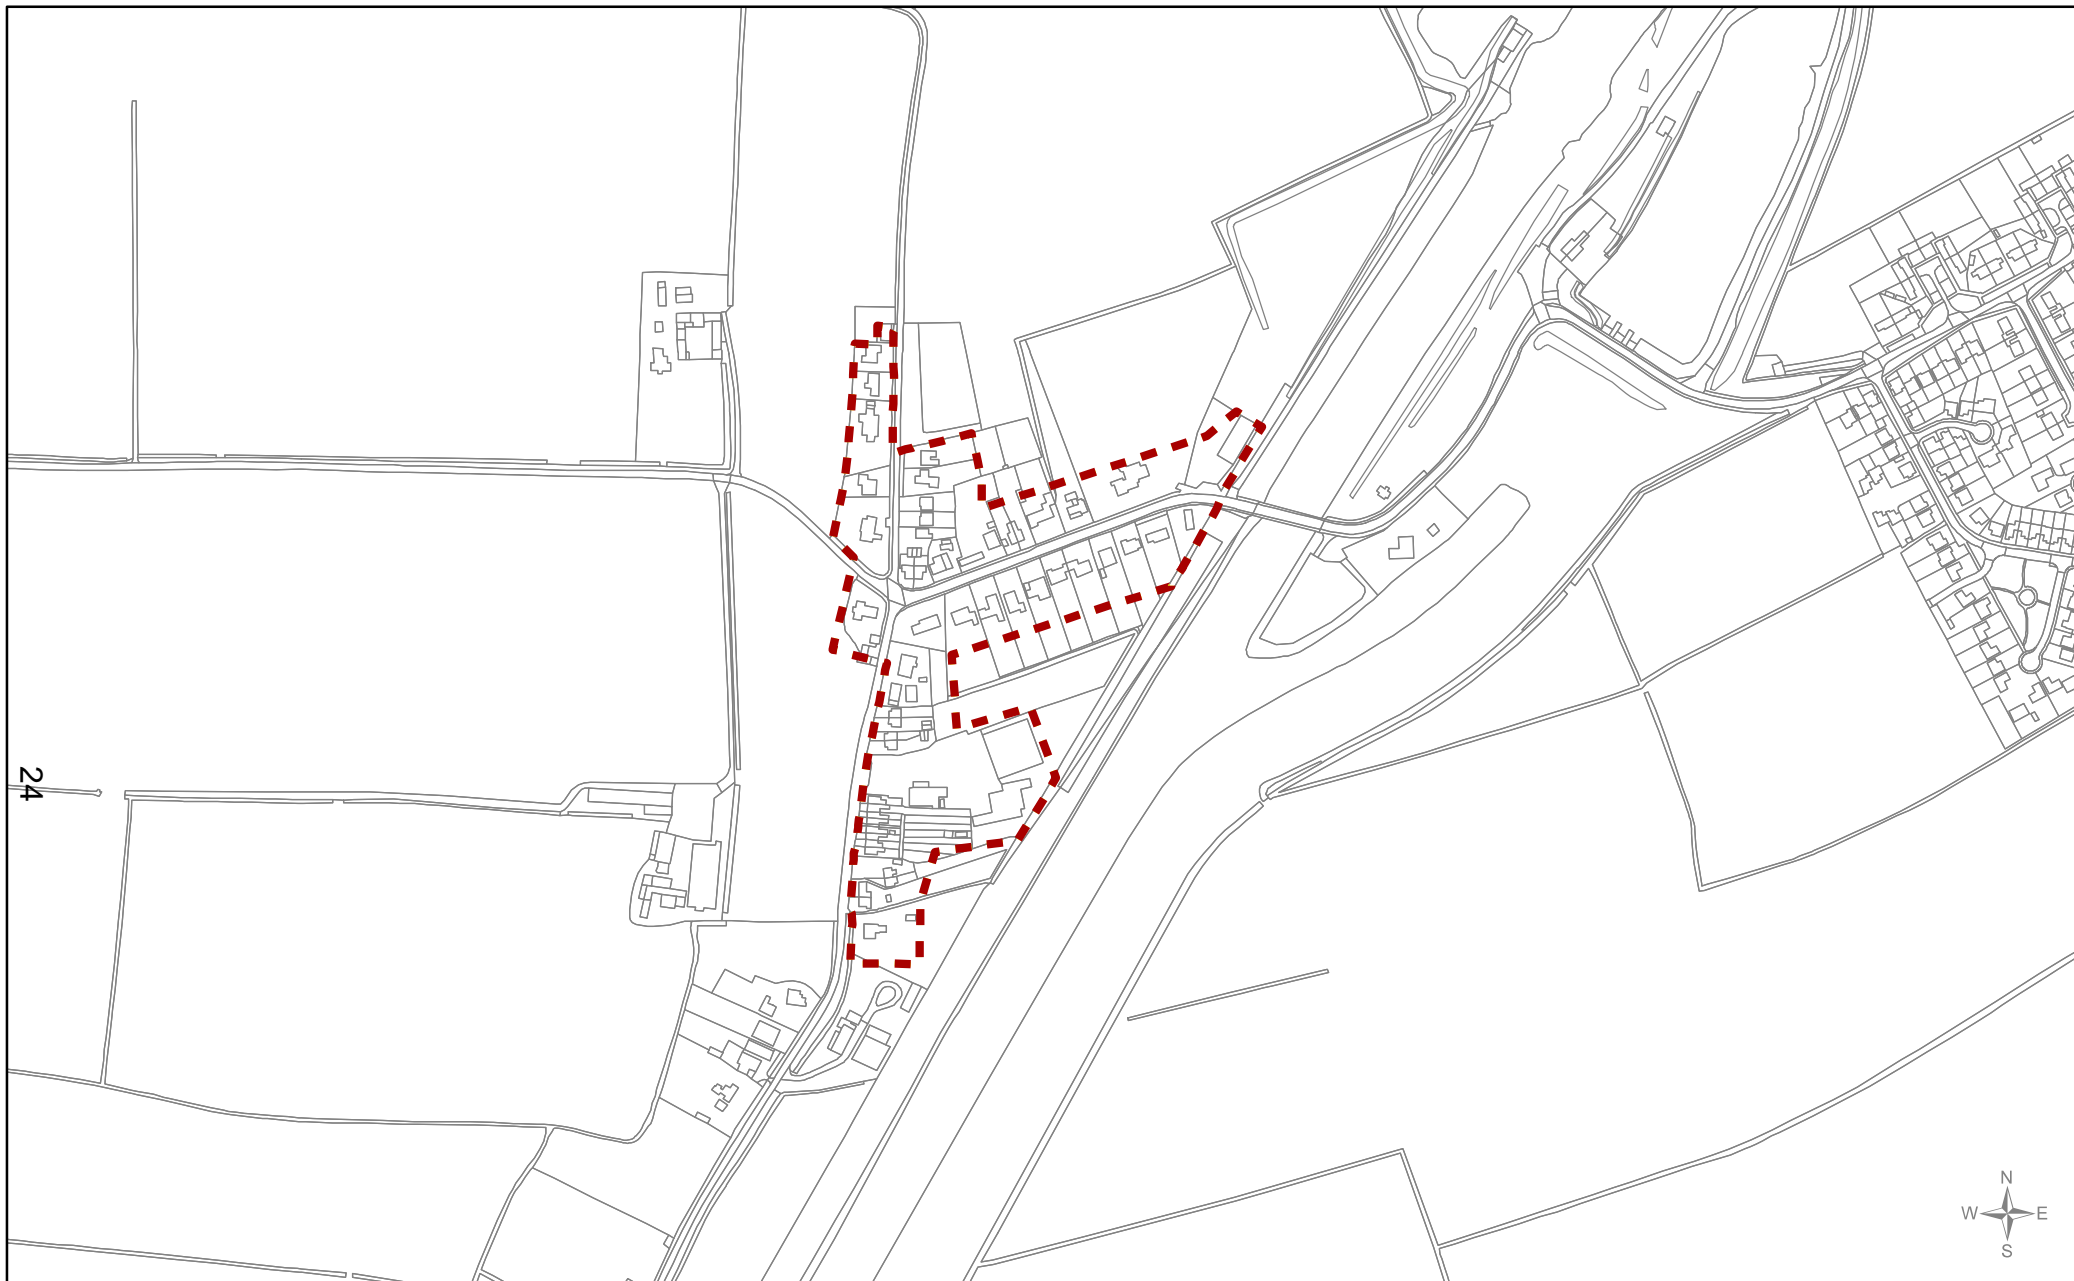

Borough Council of  
**King's Lynn &  
 West Norfolk**  
 Tel. 01553 616200  
 Email: [ldf@west-norfolk.gov.uk](mailto:ldf@west-norfolk.gov.uk)



**Wighenhall St Mary the Virgin  
 Evolved DRAFT Development Boundary Suggestion**

**Local Plan review (2016 - 2036)  
 'Smaller Villages and Hamlets'**


Scale  
**1:5,000**


Drawn by  
**FB/PP**

Date  
**08/09/2017**


Reference Number  
**035b**




**Legend**

 Draft boundary suggestions reviewed

 First draft boundary suggestion

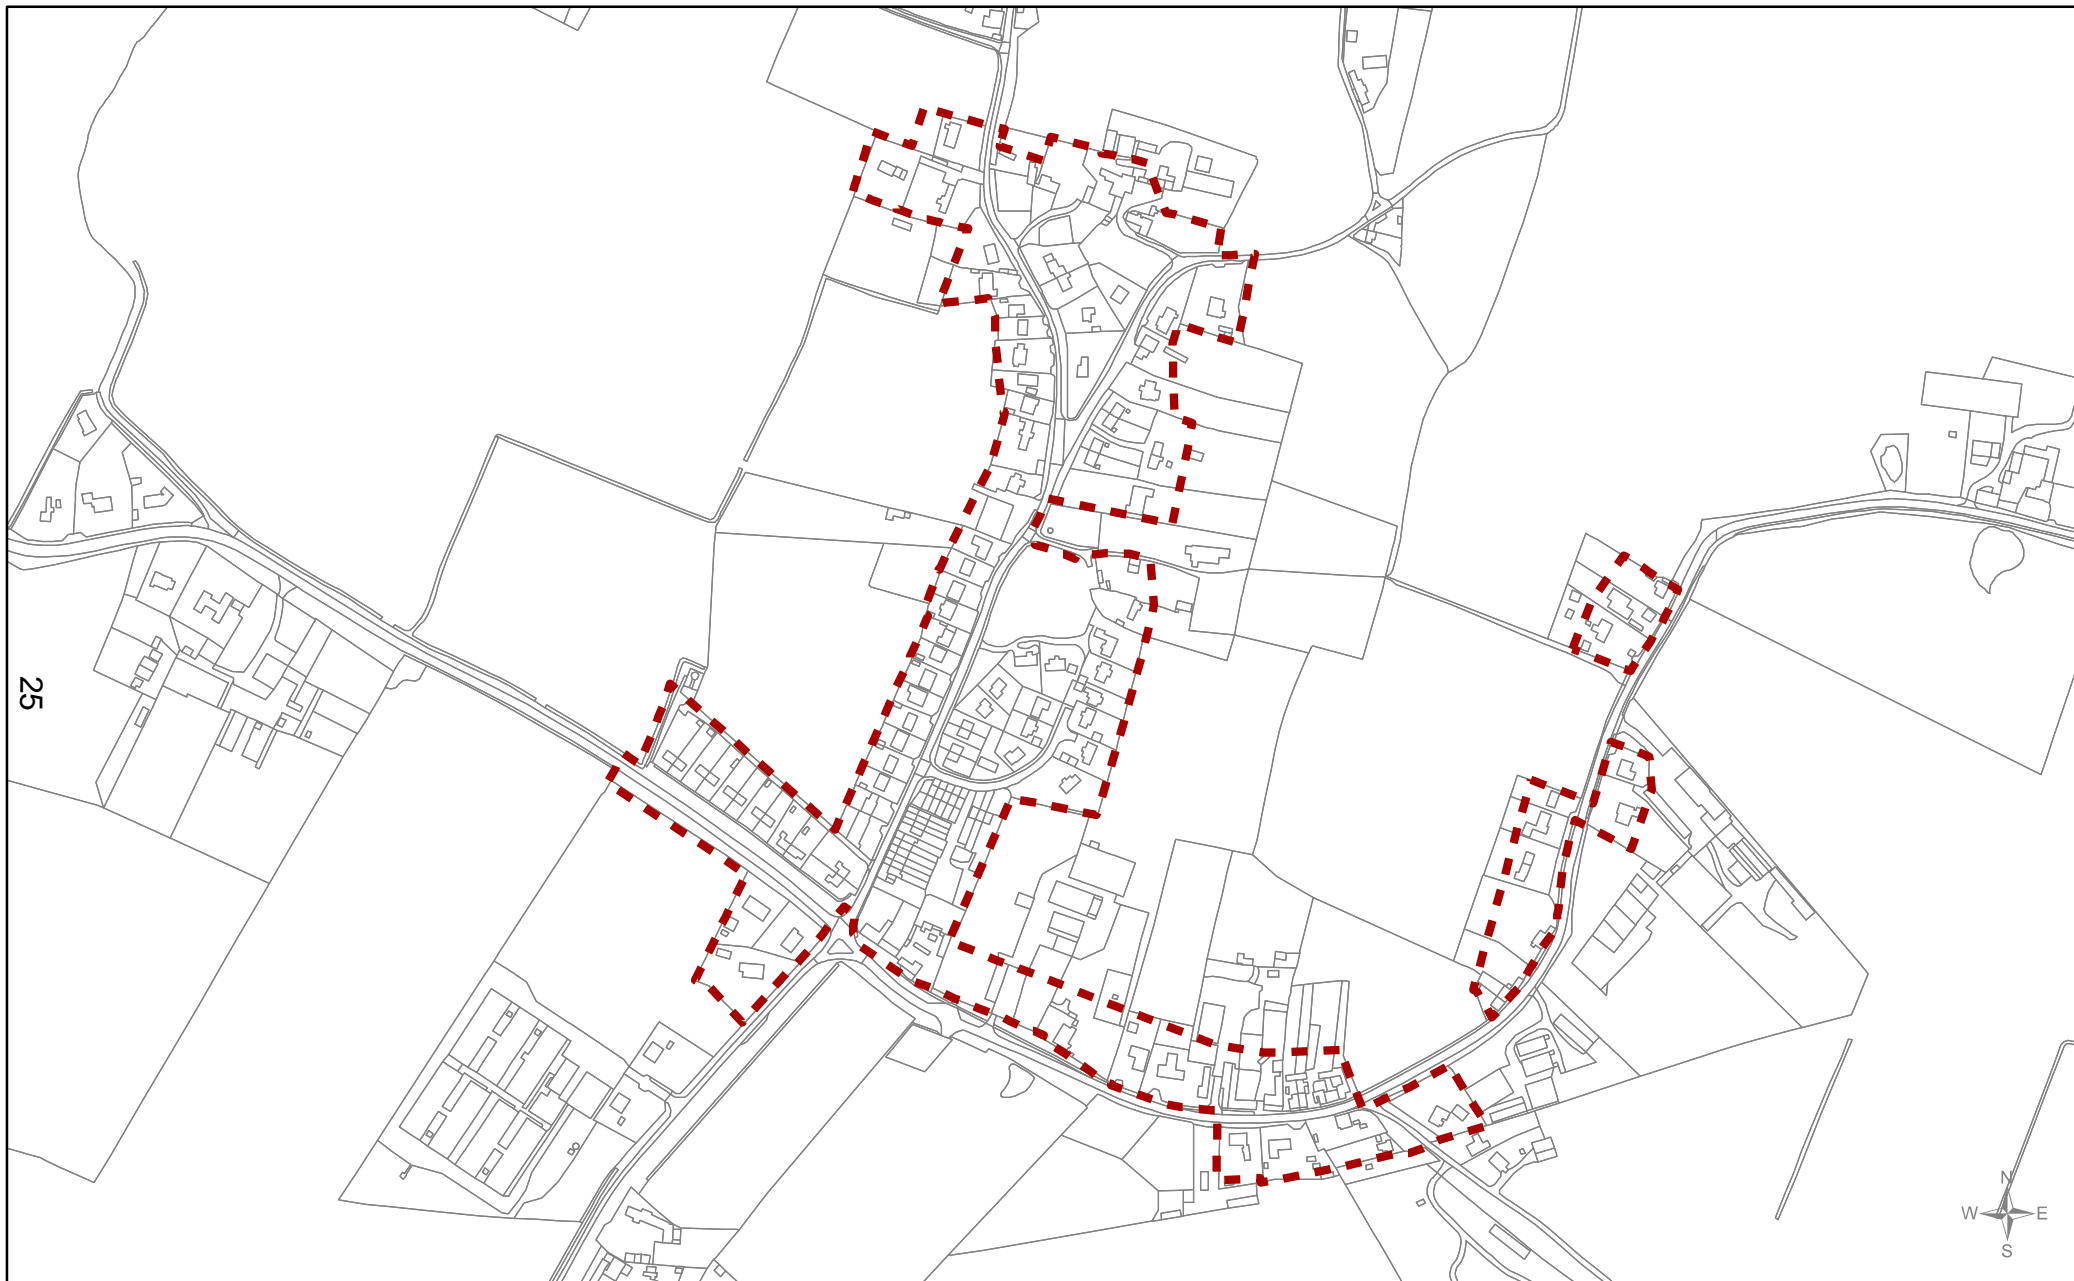© Crown copyright and  
 database rights 2017  
 Ordnance Survey 100024314



Borough Council of <b>King's Lynn &amp; West Norfolk</b> Tel. 01553 616200 Email: <a href="mailto:ldf@west-norfolk.gov.uk">ldf@west-norfolk.gov.uk</a> 	<b>Wretton</b> <b>Evolved DRAFT Development Boundary Suggestion</b>	Scale <b>1:5,000</b>	Date <b>08/09/2017</b>	<b>Legend</b>  Draft boundary suggestions reviewed  First draft boundary suggestion	© Crown copyright and database rights 2017 Ordnance Survey 100024314
	<b>Local Plan review (2016 - 2036)</b> <b>'Smaller Villages and Hamlets'</b>	Drawn by <b>FB/PP</b>	Reference Number <b>036b</b>		